

WALTHALL
E 2030
12-3-80

MISSISSIPPI
BOARD OF WATER COMMISSIONERS
416 North State Street
Jackson, Mississippi 39201

WATER WELL DRILLERS LOG

12-3-1980 Fleming's Dr. Walthall
date well completed firm name county well located

LANDOWNER:

N. L. Coates

R.R. Fleming's
(mailing address)

description of formations encountered

from to

Red Clay	0	20
Red Sand	20	100
Coarse Sand & Gravel	100	116

WELL LOCATION:

sec. 15 T. 2 N. R. 10 E. S. W
2 miles U of Fleming's
(distance) (direction) (nearest town)

WELL PURPOSE:

(home, irrigation, municipal, industrial)

WELL COMPLETION DATA:

- diameter (inches) 4
- total depth (feet) 116
- static water level (feet) 80 below above top of ground.
- casing PVC, 108, (material) (depth)
4 (size) if telescope see back.
- screen 8, 108 (length) (depth to top)
4, PVC (size) (material)
- pump 1/2, 10 (HP) (yield gpm)
Ela (type power)
- electric log no (yes or no)
(organization running log)
- how well bottom plugged Sealed

DEPT. OF NATURAL RESOURCES
BUREAU OF LAND & WATER RESOURCES


DRILLERS REMARKS:

DEC 9 1980

RECEIVED

If well telescopes please sketch and show depths.

GROUND LEVEL

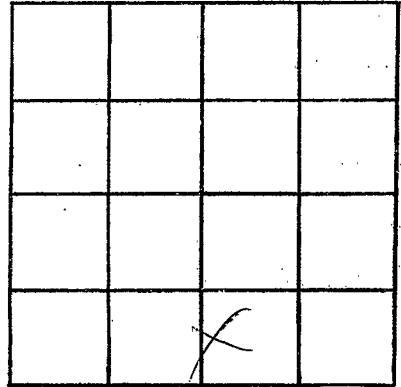

SECTION 15

Please indicate well location X.

ADDITIONAL INFORMATION

If more than one screen, show locations of each on sketch.