

Walthall  
E 2051  
8-25-80

MISSISSIPPI  
BOARD OF WATER COMMISSIONERS  
416 North State Street  
Jackson, Mississippi 39201

WATER WELL DRILLERS LOG

Aug 25 1980 Revere Well Dr. Walthall  
date well completed firm name county well located

LANDOWNER:  
George W. Garner  
(mailing address)

WELL LOCATION:  
sec. 25 T. 2 N. R. 9 E  
6 1/2 miles west of Fayetteville  
(distance) (direction) (nearest town)

WELL PURPOSE: home  
(home, irrigation, municipal, industrial)

WELL COMPLETION DATA:

(1) diameter (inches) 4"

(2) total depth (feet) 200

(3) static water level (feet) 55 below above top of ground.

(4) casing plaster bottom  
(material) (depth)

(size) if telescope see back.

(5) screen 10', 192'  
(length) (depth to top)

4", plaster  
(size) (material)

(6) pump 1/2 hp, 10  
(HP) (yield gpm).

elect  
(type power)

(7) electric log no  
(yes or no)

(organization running log)

description of formations encountered	from	to
Clay & gravel	0	18
Soft gravel	18	40
blue chalk	40	170
fine sand	170	193
Coarse sand	193	202


(8) how well bottom plugged  
wooden plug

DRILLERS REMARKS:

DEPT. OF NATURAL RESOURCES  
BUREAU OF LAND & WATER RESOURCES  
MAY 14 1981  
RECEIVED

If well telescopes please sketch and show depths.

GROUND LEVEL

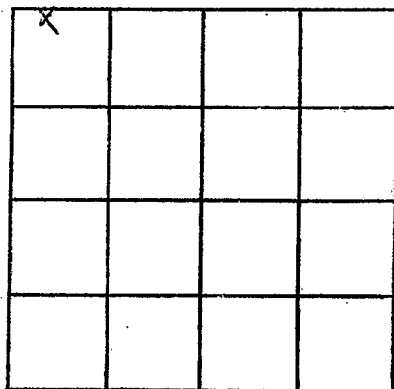

SECTION 25

Please indicate well location X.

ADDITIONAL INFORMATION

If more than one screen, show locations of each on sketch.