

WALTHALL
E 2053
7-9-80

MISSISSIPPI
BOARD OF WATER COMMISSIONERS
416 North State Street
Jackson, Mississippi 39201

WATER WELL DRILLERS LOG

7-9 1980 Fitzgerald Well Dr Walthall
date well completed firm name county well located

LANDOWNER:	description of formations encountered	from	to
<u>Jewell Deen</u> <u>R.R. - Tylertown</u> (mailing address)			
WELL LOCATION:			
sec. <u>7</u> T <u>2</u> N R <u>10</u> E S W			
<u>9</u> miles <u>W</u> of <u>Tylertown</u> (distance) (direction) (nearest town)			
WELL PURPOSE: <u>Home</u> (home, irrigation, municipal, industrial)			
WELL COMPLETION DATA:			
(1) diameter (inches) <u>4</u>			
(2) total depth (feet) <u>237</u>			
(3) static water level (feet) <u>140</u> below top of ground.			
(4) casing <u>PVC</u> , <u>229</u> , (material) (depth) <u>4</u> (size) if telescope see back.			
(5) screen <u>8</u> , <u>229</u> (length) (depth to top) <u>4</u> , <u>PVC</u> (size) (material)			
(6) pump <u>1/2</u> , <u>10</u> (HP) (yield gpm) <u>Electric</u> (type power)			
(7) electric log <u>No</u> (yes or no) <u>Electric</u> (organization running log)			
(8) how well bottom plugged <u>Sealed</u>			
DRILLERS REMARKS:			


DEPT. OF NATURAL RESOURCES
BUREAU OF LAND & WATER RESOURCES

SEP 8 - 1980

RECEIVED

If well telescopes please sketch and show depths.

GROUND LEVEL

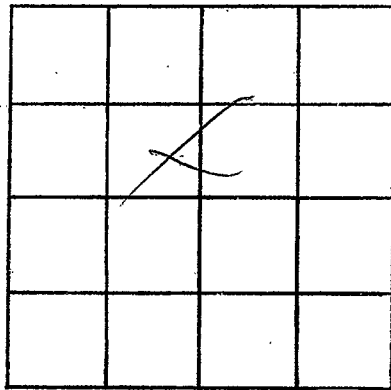

SECTION 2

Please indicate well location X.

ADDITIONAL INFORMATION

If more than one screen,
show locations of each on sketch.