

WALTHALL  
E 2055  
2-2-81

MISSISSIPPI  
BOARD OF WATER COMMISSIONERS  
416 North State Street  
Jackson, Mississippi 39201

WATER WELL DRILLERS LOG

2-2 1981 *Fitzgerald Well Serv* *Walthall*  
date well completed firm name county well located

LANDOWNER:

*Misc Baptist Church*

*R.R. Celestevon*  
(mailing address)

description of formations encountered

from to

*Red Clay* 0 20

*Red Sand* 20 90

*Coarse Sandstone* 90 131

WELL LOCATION:

sec 9 T 2 (N) R 10 (E)  
S  
4 miles W of Fayette  
(distance) (direction) (nearest town)

WELL PURPOSE:

*Flow*  
(home, irrigation, municipal, industrial)

WELL COMPLETION DATA:

- (1) diameter (inches) 4  
(2) total depth (feet) 131  
(3) static water level (feet) 80 below above top of ground.

(4) casing PUL, 123  
(material) (depth)

4  
(size) If telescope see back.

(5) screen 8, 123  
(length) (depth to top)

4, PUL  
(size) (material)

(6) pump 1/2, 10  
(HP) (yield gpm)

Elco  
(type power)

(7) electric log yes  
(yes or no)

(organization running log)

(8) how well bottom plugged Sealed

DRILLERS REMARKS:


DEPT. OF NATURAL RESOURCES  
BUREAU OF LAND & WATER RESOURCES

APR 28 1981

RECEIVED

If well telescopes please sketch and show depths.

GROUND LEVEL

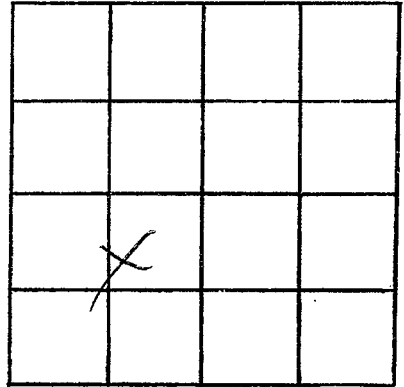

SECTION 9

Please indicate well location X.

ADDITIONAL INFORMATION

If more than one screen,  
show locations of each on sketch.