


Walshall
E 2080
6-3-81

MISSISSIPPI
BOARD OF WATER COMMISSIONERS
416 North State Street
Jackson, Mississippi 39201

WATER WELL DRILLERS LOG


6-3 1981 Flanckwell Inc Walshall
date well completed firm name county well located

LANDOWNER:	description of formations encountered	from	to
<u>Raymond Leart</u>			
<u>R.R. Lyleton, Jr.</u> (mailing address)	<u>Red clay</u> <u>Red sand & gravel</u> <u>Coarse sand & gravel</u>	<u>0</u> <u>20</u> <u>105</u>	<u>20</u> <u>105</u> <u>115</u>
WELL LOCATION: sec. <u>29</u> T. <u>2</u> N. R. <u>10</u> E S W <u>4</u> miles <u>W</u> of <u>Lyleton</u> (distance) (direction) (nearest town)			
WELL PURPOSE: <u>Home</u> (home, irrigation, municipal, industrial)			
WELL COMPLETION DATA: (1) diameter (inches) <u>4</u> (2) total depth (feet) <u>115</u> (3) static water level (feet) <u>20</u> below top of ground. (4) casing <u>PVC</u> , <u>107</u> , (material) (depth) <u>4</u> (size) if telescope see back. (5) screen <u>8</u> , <u>107</u> (length) (depth to top) <u>4</u> , <u>PVC</u> (size) (material) (6) pump <u>1/2</u> , <u>10</u> (HP) (yield gpm) <u>elec</u> (type power) (7) electric log <u>no</u> (yes or no) (organization running log) (8) how well bottom plugged <u>sealed</u>			
DRILLERS REMARKS:			

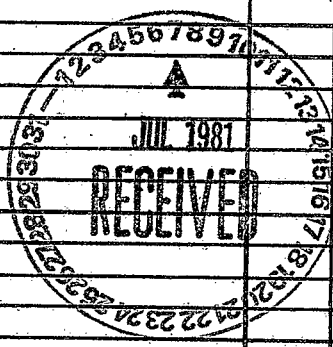

If well telescopes please sketch and show depths.

GROUND LEVEL

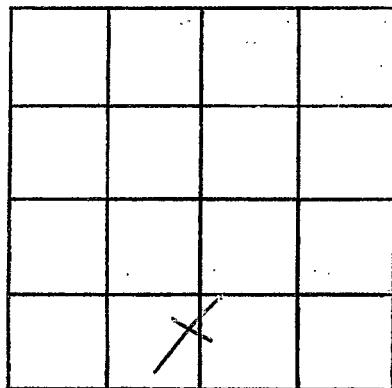

SECTION 29

Please indicate well location X.

ADDITIONAL INFORMATION

If more than one screen,
show locations of each on sketch.