

WALTHALL

E 2057

7-27-81

7-27

19 81

F. General Steel Ltd

Walthall

date well completed

firm name

county well located

MISSISSIPPI
 BOARD OF WATER COMMISSIONERS
 416 North State Street
 Jackson, Mississippi 39201

WATER WELL DRILLERS LOG

LANDOWNER:

Doug Prescott

R.R. Tylertown
(mailing address)

description of formations encountered

from to

Red clay

0 25

Blue clay

25 80

9" fine sand

80 110

Coarse sand & gravel

110 120

WELL LOCATION:

sec. 19 T 2 N R 10 E
S W

6.2 miles W of Tylertown
(distance) (direction) (nearest town)

WELL PURPOSE:

Home
(home, irrigation, municipal, industrial)

WELL COMPLETION DATA:

- (1) diameter (inches) 4
- (2) total depth (feet) 120
- (3) static water level (feet) 15 below above top of ground.

- (4) casing PVC, 112, (material) (depth)
4 (size) if telescope see back.

- (5) screen 8, 112 (length) (depth to top)
4, PVC (size) (material)


- (6) pump 1/2, 10 (HP) (yield gpm)
elec (type power)

- (7) electric log (yes or no)

(organization running log)


- (8) how well bottom plugged sand ok

DRILLERS REMARKS:

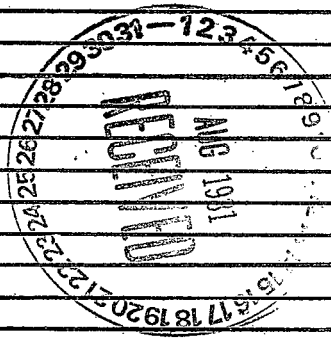

If well telescopes please sketch and show depths.

GROUND LEVEL

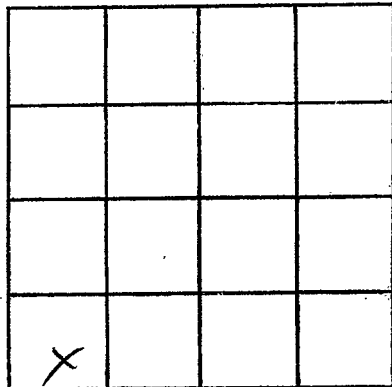

SECTION 19

Please indicate well location X.

ADDITIONAL INFORMATION

If more than one screen, show locations of each on sketch.