

WALTHALL  
E 20581  
7-27-81

MISSISSIPPI  
 BOARD OF WATER COMMISSIONERS  
 416 North State Street  
 Jackson, Mississippi 39201

WATER WELL DRILLERS LOG

7-27 1981  
 date well completed

F. G. ...  
 firm name

Walthall  
 county well located

LANDOWNER:

Doyle Rushing -

R.B. ...  
 (mailing address)

description of formations encountered

from to

<u>Red clay</u>	<u>0</u>	<u>20</u>
<u>blue chalk</u>	<u>20</u>	<u>152</u>
<u>Coarse sandstone</u>	<u>152</u>	<u>168</u>

WELL LOCATION:


sec. 19 T 2 N R. 10 E  
 S W  
6 miles W of Gilberton  
 (distance) (direction) (nearest town)

WELL PURPOSE: Home  
 (home, irrigation, municipal, industrial)

WELL COMPLETION DATA:


- (1) diameter (inches) 4
- (2) total depth (feet) 168
- (3) static water level (feet) 8 below above top of ground.
- (4) casing PVC, 152,  
 (material) (depth)  
4 if telescope see back.  
 (size)
- (5) screen 16, 152  
 (length) (depth to top)  
4, PVC  
 (size) (material)
- (6) pump None, 8  
 (HP) (yield gpm)  
Flow  
 (type power)
- (7) electric log No  
 (yes or no)  
 (organization running log)
- (8) how well bottom plugged Seal OK

DRILLERS REMARKS:

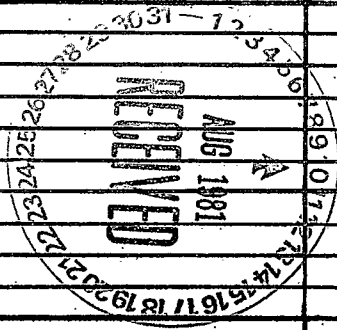

If well telescopes please sketch and show depths.

GROUND LEVEL

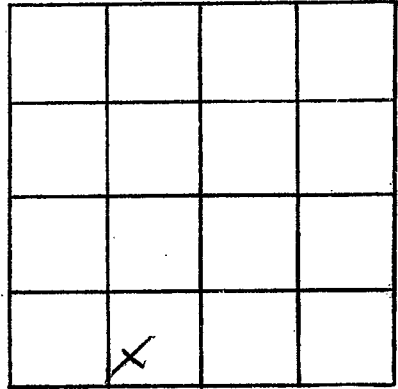

SECTION 19

Please indicate well location X.

ADDITIONAL INFORMATION

If more than one screen, show locations of each on sketch.