

Walthall
E 2000

MISSISSIPPI
BOARD OF WATER COMMISSIONERS
416 North State Street
Jackson, Mississippi 39201

WATER WELL DRILLERS LOG

3-26 1982 Fitzgerald Well Serv Walthall
date well completed firm name county well located

LANDOWNER:
T.N. Gilbert
R.R. Tylertown
(mailing address)

description of formations encountered	from	to
Red clay	0	20
Red gravel	20	90
white & blue chalk	90	255
Coarse sand & gravel	255	276

WELL LOCATION:
sec. 6 T 2 N R 10 E
S W
7 miles W of Tylertown
(distance) (direction) (nearest town)

WELL PURPOSE: Home
(home, irrigation, municipal, industrial)

- WELL COMPLETION DATA:
- (1) diameter (inches) 4
 - (2) total depth (feet) 270
 - (3) static water level (feet) 150 below top of ground.
 - (4) casing PVC 262 (material) (depth)
4 (size) If telescope see back.
 - (5) screen 8 262 (length) (depth to top)
4 (size) PVC (material)
 - (6) pump 1/2 10 (HP) (yield gpm)
Eln (type power)
 - (7) electric log no (yes or no)
 - (organization running log)
 - (8) how well bottom plugged Sand Plug

DRILLERS REMARKS:


DEPT. OF NATURAL RESOURCES
BUREAU OF LAND & WATER RESOURCES

MAY 25 1982

RECEIVED

If well telescopes please sketch and show depths.

GROUND LEVEL

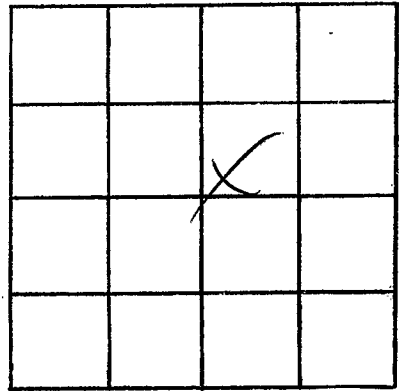

SECTION 6

Please indicate well location X.

ADDITIONAL INFORMATION

If more than one screen, show locations of each on sketch.