

Walthall
E
2001

MISSISSIPPI
BOARD OF WATER COMMISSIONERS
416 North State Street
Jackson, Mississippi 39201

WATER WELL DRILLERS LOG

6-16-1982 date well completed
Walthall firm name
Walthall county well located

LANDOWNER:
J.W. Lee
P.R. Tipton
(mailing address)

description of formations encountered	from	to
Red clay	0	20
Red gravel & sand	20	100
Coarse sand & gravel	100	117

WELL LOCATION:
sec. 22 T 2 N R 10 E
S
2 miles W of Tipton
(distance) (direction) (nearest town)

WELL PURPOSE: Home
(home, irrigation, municipal, industrial)

- WELL COMPLETION DATA:
- (1) diameter (inches) 4
 - (2) total depth (feet) 117
 - (3) static water level (feet) 70 below top of ground.
 - (4) casing PVC, 109, (material) (depth)
4 (size) If telescope see back.
 - (5) screen 8, 109 (length) (depth to top)
4 (size) PVC (material)
 - (6) pump 1/2, 10 (HP) (yield gpm)
Ela (type power)
 - (7) electric log No (yes or no)
(organization running log)
 - (8) how well bottom plugged L.H.K.

DEPT. OF NATURAL RESOURCES
BUREAU OF LAND & WATER RESOURCES


JUL 7 1982

RECEIVED

DRILLERS REMARKS:

If well telescopes please sketch and show depths.

GROUND LEVEL

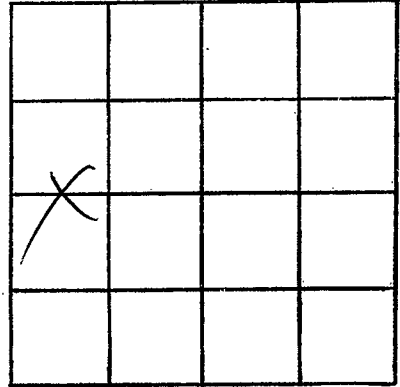

SECTION 22

Please indicate well location X.

ADDITIONAL INFORMATION

If more than one screen, show locations of each on sketch.