

Walthall
 E 2000

MISSISSIPPI DEPARTMENT OF NATURAL RESOURCES
 Bureau of Land and Water Resources
 Southport Mall
 P.O. Box 10631
 Jackson, Mississippi 39209
 WATER WELL DRILLERS LOG

March 19 1982 Rever Well Dr. Walthall
 date well completed firm name county well located

LANDOWNER:
Wilton Jackson
Rt Magnolia
 (mailing address)

| description of formations encountered | from | to |
|---------------------------------------|------|-----|
| Clay | 0 | 5- |
| sand & gravel | 5 | 22 |
| blue chert | 22 | 70 |
| fine sand | 70 | 90 |
| blue clay | 90 | 110 |
| fine yellow sand | 110 | 160 |
| sand & fine gravel | 160 | 178 |

WELL LOCATION:
 sec 26 T 2 N R 9 E
6 1/2 miles West of Walthall
 (distance) (direction) (nearest town)

WELL PURPOSE: House
 (home, irrigation, municipal, industrial)

- WELL COMPLETION DATA:
- (1) diameter (inches) 4"
 - (2) total depth (feet) 178
 - (3) static water level (feet) 99 ^{below} top of ground
 - (4) casing plastic bottom
 (material) (depth)
 - (5) screen 5' 173'
 (length) (depth to top)
 - (6) pump 4" plastic
 (size) (material)
 - (7) pump 1/2 HP 100
 (type power) (yield gpm)
 - (8) electric log no
 (yes or no)
 - (9) no
 (organization running log)
 - (10) how well bottom plugged back wash

DRILLERS REMARKS:


DEPT. OF NATURAL RESOURCES
 BUREAU OF LAND & WATER RESOURCES

AUG - 5 1982

RECEIVED

If well telescopes please sketch and show depths.

GROUND LEVEL

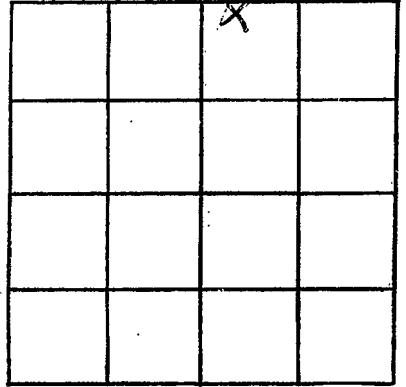

SECTION 25

Please indicate well location X.

ADDITIONAL INFORMATION

If more than one screen,
show locations of each on sketch.