

MISSISSIPPI DEPARTMENT OF NATURAL RESOURCES

Bureau of Land and Water Resources

Southport Mall

P.O. Box 10631

Jackson, Mississippi 39209

WATER WELL DRILLERS LOG

March 15 1983 *Reuss Well Drilling* *Walsh*  
 date well completed firm name county well located

LANDOWNER:  
*Jesse Mae Hampton*  
*Rt 3 Tule town*  
 (mailing address)

WELL LOCATION:  
 sec 5 T 2 N R 10 E  
5 miles W-NW of Tule town  
 (distance) (direction) (nearest town)

WELL PURPOSE: Home  
 (home, irrigation, municipal, industrial)

WELL COMPLETION DATA:

(1) diameter (inches) 4"

(2) total depth (feet) 235

(3) static water level (feet) 120 below above top of ground.

(4) casing plastic bottom  
 (material) (depth)

— if telescope see back.  
 (size)

(5) screen 5' 250'  
 (length) (depth to top)

4" plastic  
 (size) (material)

(6) pump 3/4 12  
 (HP) (yield gpm)

split  
 (type power)

(7) electric log no  
 (yes or no)

—  
 (organization running log)

description of formations encountered	from	to
<i>Red clay</i>	<i>0</i>	<i>24</i>
<i>Red sand</i>	<i>24</i>	<i>80</i>
<i>Chalk sand</i>	<i>80</i>	<i>110</i>
<i>sand + gravel</i>	<i>110</i>	<i>130</i>
<i>Blue Chalk</i>	<i>130</i>	<i>210</i>
<i>fine sand</i>	<i>210</i>	<i>235</i>
<i>coarse sand</i>	<i>235</i>	<i>255</i>


(8) how well bottom plugged  
plastic back to end

DRILLERS REMARKS: —

DEPT OF NATURAL RESOURCES  
 BUREAU OF LAND & WATER RESOURCES  
 JUN 17 1983  
**RECEIVED**

If well telescopes please sketch and show depths.

GROUND LEVEL

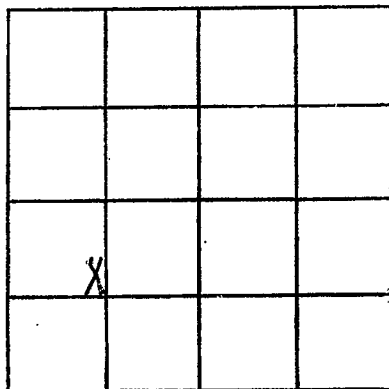

SECTION 5

Please indicate well location X.

ADDITIONAL INFORMATION

If more than one screen,  
show locations of each on sketch.