

MISSISSIPPI DEPARTMENT OF NATURAL RESOURCES

Bureau of Land and Water Resources

Southport Mall

P.O. Box 10631

Jackson, Mississippi 39209

WATER WELL DRILLERS LOG

TOM GRIFFITH

PLUMBING & WELL SERVICE INC.

Walthall

Walthall  
E 2065  
4/27/83

4-27 1983  
date well completed

320 MATSON AVE.

county well located

LANDOWNER Leroy Dillon

description of formations encountered

from

to

Rt-1

Tylertown, MS  
(mailing address)

Topsoil

0'

1'

Chalk

1'

25'

Gravel

25'

80'

Chalk

80'

85'

Gravel

85'

120'

WELL LOCATION:

sec. 14 T 20 N R 10 E  
S W

5 miles W of Tylertown  
(distance) (direction) (nearest town)

WELL PURPOSE: home  
(home, irrigation, municipal, industrial)

WELL COMPLETION DATA:

- (1) diameter (inches) 4"
- (2) total depth (feet) 120'
- (3) static water level (feet) 80' below above top of ground.

(4) casing PVC 110'  
(material) (depth)

N/A if telescope see back.  
(size)

(5) screen 10' 120'  
(length) (depth to top)

4" PVC  
(size) (material)

(6) pump 1/2 12  
(HP) (yield gpm)

electric  
(type power)

(7) electric log none  
(yes or no)

N/A  
(organization running log)

(8) how well bottom plugged check  
valve

DRILLERS REMARKS:


DEPT. OF NATURAL RESOURCES  
BUREAU OF LAND & WATER RESOURCES

MAY 18 1983

RECEIVED

If well telescopes please sketch and show depths.

GROUND LEVEL

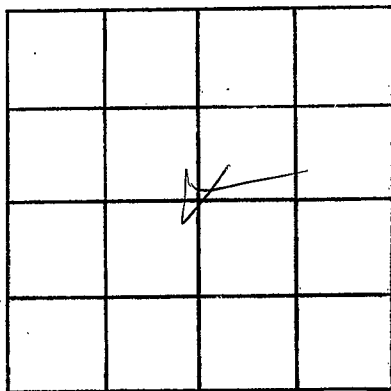

SECTION 14

Please indicate well location X.

ADDITIONAL INFORMATION

If more than one screen,  
show locations of each on sketch.