

Walthall
E 20000

MISSISSIPPI
 BOARD OF WATER COMMISSIONERS
 416 North State Street
 Jackson, Mississippi 39201

WATER WELL DRILLERS LOG

7-25 1983 F. Gumbel & Son Walthall
 date well completed firm name county well located

LANDOWNER:	description of formations encountered	from	to
<u>Walter Kinchen</u> <u>RR. Lyntown</u> (mailing address)			
WELL LOCATION:			
sec. <u>6</u> T. <u>2</u> N R. <u>10</u> E S W			
<u>7</u> miles <u>W</u> of <u>Lyntown</u> (distance) (direction) (nearest town)			
WELL PURPOSE: (home, irrigation, municipal, industrial)			
WELL COMPLETION DATA:			
(1) diameter (inches) <u>4</u>			
(2) total depth (feet) <u>133</u>			
(3) static water level (feet) <u>105</u> below top of ground.			
(4) casing <u>PVC</u> , <u>125</u> , (material) (depth)			
<u>4</u> If telescope see back. (size)			
(5) screen <u>8</u> , <u>125</u> (length) (depth to top)			
<u>4</u> , <u>PVC</u> (size) (material)			
(6) pump <u>1/2</u> , <u>10</u> (HP) (yield gpm)			
<u>Elc</u> (type power)			
(7) electric log <u>No</u> (yes or no)			
<u>South</u> (organization running log)			
(8) how well bottom plugged <u>Sealed</u>			
DRILLERS REMARKS:			


DEPT. OF NATURAL RESOURCES
 BUREAU OF LAND & WATER RESOURCES

AUG 15 1983

RECEIVED

If well telescopes please sketch and show depths.

GROUND LEVEL

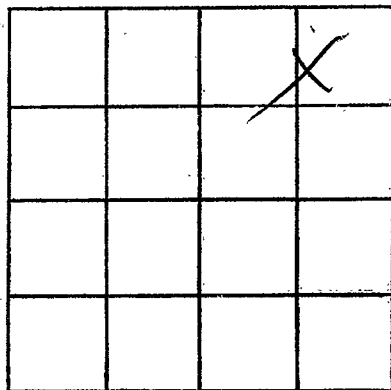

SECTION 6

Please indicate well location X.

ADDITIONAL INFORMATION

If more than one screen, show locations of each on sketch.