

MISSISSIPPI DEPARTMENT OF NATURAL RESOURCES

Bureau of Land and Water Resources

Southport Mall

P.O. Box 10631

Jackson, Mississippi 39209

WATER WELL DRILLERS LOG

Wattball
E 2007

1-11 1984
date well completed

F. Small well Sew
firm name


Wattball
county well located

LANDOWNER:	description of formations encountered	from	to
<u>A. S. BAKER</u>			
<u>R.R. Ruth ms</u> (mailing address)	<u>Red clay</u>	<u>0</u>	<u>20</u>
	<u>Red sand</u>	<u>20</u>	<u>80</u>
	<u>White chalk</u>	<u>80</u>	<u>135</u>
	<u>Coarse sandstone</u>	<u>135</u>	<u>150</u>
WELL LOCATION:			
sec. <u>5</u> T <u>2</u> N R <u>10</u> E S W			
<u>2</u> miles <u>W</u> of <u>SHADY GROVE</u> (distance) (direction) (nearest town)			
WELL PURPOSE:			
(home, irrigation, municipal, industrial) <u>Home</u>			
WELL COMPLETION DATA:			
(1) diameter (inches) <u>4</u>			
(2) total depth (feet) <u>150</u>			
(3) static water level (feet) <u>110</u> below top of ground.			
(4) casing <u>PVC</u> , <u>142</u> (material) (depth)			
<u>4</u> if telescope see back. (size)			
(5) screen <u>8</u> , <u>142</u> (length) (depth to top)			
<u>4</u> , <u>PVC</u> (size) (material)			
(6) pump <u>1/2</u> , <u>10</u> (HP) (yield gpm)			
<u>elc</u> (type power)			
(7) electric log <u>no</u> (yes or no)			
(organization running log)			
(8) how well bottom plugged <u>Sand</u>			
DRILLERS REMARKS:			


RECEIVED
MAR 6 1984
BUREAU OF LAND AND WATER RESOURCES
DEPT. OF NATURAL RESOURCES

If well telescopes please sketch and show depths.

GROUND LEVEL

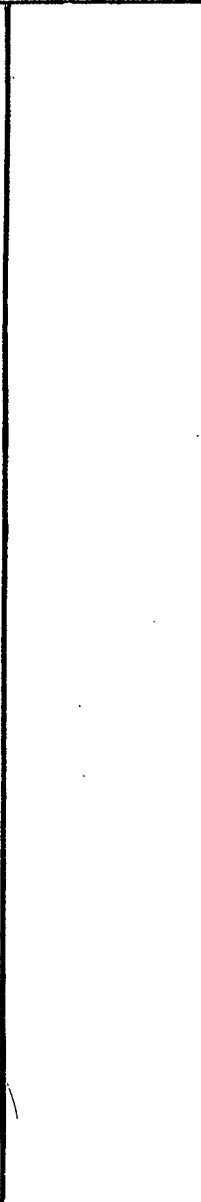

If more than one screen, show locations of each on sketch.

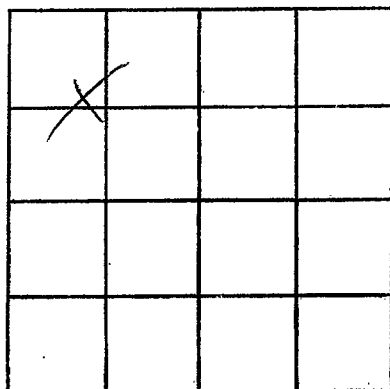

SECTION 5

Please indicate well location X.

ADDITIONAL INFORMATION

