

MISSISSIPPI DEPARTMENT OF NATURAL RESOURCES

Bureau of Land and Water Resources

Southport Mall

P.O. Box 10631

Jackson, Mississippi 39209

WATER WELL DRILLERS LOG

Walthall
E 2009

Jan 9 1984 Acme Well Dr. Walthall
date well completed firm name county well located

LANDOWNER:
Ms. Greg McDaniel
Ht. Tylertown
(mailing address)

description of formations encountered	from	to
<u>hard clay</u>	<u>0</u>	<u>22</u>
<u>gravel sand</u>	<u>22</u>	<u>55</u>
<u>blue clay</u>	<u>55</u>	<u>81</u>
<u>brown gravel</u>	<u>81</u>	<u>94</u>

WELL LOCATION:
sec. 19 T-2 N R-10 E
5 1/2 miles west of Tylertown
(distance) (direction) (nearest town)

WELL PURPOSE: rent house
(home, irrigation, municipal, industrial)

- WELL COMPLETION DATA:
- (1) diameter (inches) 4"
 - (2) total depth (feet) 94'
 - (3) static water level (feet) 6' ~~above~~ below top of ground.
 - (4) casing plastic, partition
(material) (depth)
 - if telescope see back.
(size)
 - (5) screen 6', 88'
(length) (depth to top)
 - 4", plastic
(size) (material)
 - (6) pump 1/2 10
(HP) (yield gpm)
 - split
(type power)
 - (7) electric log no
(yes or no)
 - (organization running log)
 - (8) how well bottom plugged back filled

DEPT. OF NATURAL RESOURCES
BUREAU OF LAND & WATER RESOURCES


JUN 11 1984

RECEIVED

DRILLERS REMARKS:

If well telescopes please sketch and show depths.

GROUND LEVEL

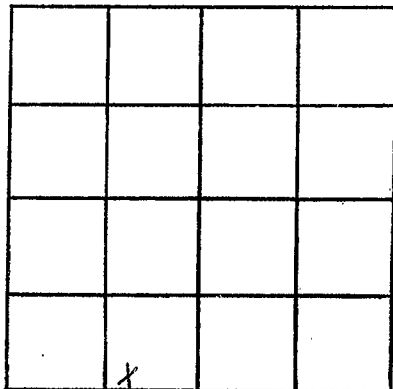

SECTION 19

Please indicate well location X.

ADDITIONAL INFORMATION

If more than one screen,
show locations of each on sketch.