

WALTHALL
E 2070

MISSISSIPPI DEPARTMENT OF NATURAL RESOURCES
Bureau of Land and Water Resources
Southport Mall
P.O. Box 10631
Jackson, Mississippi 39209
WATER WELL DRILLERS LOG

May 30 1984 Rever Wilson Walthall
date well completed firm name county well located

LANDOWNER:
A.C. Garner
Rt 3 Tylertown
(mailing address)

description of formations encountered	from	to
<u>sand + gravel</u>	<u>0</u>	<u>30</u>
<u>blue chalk</u>	<u>30</u>	<u>110</u>
<u>fine sand</u>	<u>110</u>	<u>160</u>
<u>brown sand + gravel</u>	<u>160</u>	<u>180</u>
<u>coarse sand</u>	<u>180</u>	<u>238</u>

WELL LOCATION:
25 sec 24 T 2 N R 9 E
6 miles W of Tylertown
(distance) (direction) (nearest town)

WELL PURPOSE: home
(home, irrigation, municipal, industrial)

WELL COMPLETION DATA:

(1) diameter (inches) 4"

(2) total depth (feet) 238

(3) static water level (feet) below above top of ground.

(4) casing plastic, bottom
(material) (depth)
if telescope see back.
(size)

(5) screen 10', 228'
(length) (depth to top)
4", plastic
(size) (material)

(6) pump 2 sub, 10
(HP) (yield gpm)
whit
(type power)

(7) electric log no
(yes or no)
(organization running log)

(8) how well bottom plugged
back wash

DRILLERS REMARKS:


DEPT. OF NATURAL RESOURCES
BUREAU OF LAND & WATER RESOURCES

JUL 30 1984

RECEIVED

If well telescopes please sketch and show depths.

GROUND LEVEL

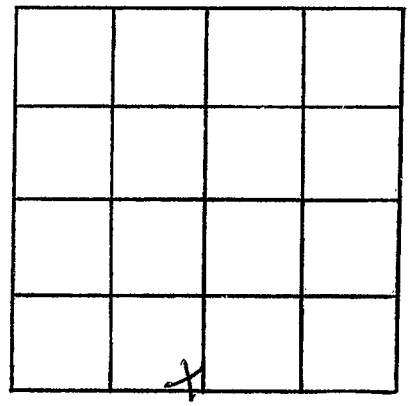

SECTION 24³

Please indicate well location X.

ADDITIONAL INFORMATION

Lined area for additional information.

If more than one screen, show locations of each on sketch.