

WALTHALL  
E 2071

MISSISSIPPI DEPARTMENT OF NATURAL RESOURCES  
Bureau of Land and Water Resources  
Southport Mall  
P.O. Box 10631  
Jackson, Mississippi 39209  
WATER WELL DRILLERS LOG

June 9 1984 *Rever Well Co* *Walthall*  
date well completed firm name county well located

LANDOWNER:  
*Mr E. Burgess*  
*Rt 3 Syletown*  
(mailing address)

description of formations encountered	from	to
<i>Red Clay</i>	<i>0</i>	<i>22</i>
<i>Red sand</i>	<i>22</i>	<i>60</i>
<i>Hard gravel sand</i>	<i>60</i>	<i>85</i>
<i>Chalky bobbly sand</i>	<i>85</i>	<i>137</i>
<i>Red gravel sand</i>	<i>137</i>	<i>160</i>

WELL LOCATION:  
sec *28* T *2* N R *10* E  
*3 1/4* miles *W* of *Syletown*  
(distance) (direction) (nearest town)

WELL PURPOSE: *Trailer*  
(home, irrigation, municipal, industrial)

WELL COMPLETION DATA:

(1) diameter (inches) *4"*

(2) total depth (feet) *160*

(3) static water level (feet) *80'* above top of ground.

(4) casing *plastic* bottom  
(material) (depth)

*1* if telescope see back.  
(size)

(5) screen *6"* *150'*  
(length) (depth to top)

*4"* *plastic*  
(size) (material)

(6) pump *3/4 hp* *12*  
(HP) (yield gpm)

*split*  
(type power)

(7) electric log *no*  
(yes or no)

(organization running log)

DEPT. OF NATURAL RESOURCES  
BUREAU OF LAND & WATER RESOURCES

JUL 30 1984


RECEIVED

(8) how well bottom/plugged  
*bad w/ ch*

DRILLERS REMARKS:

If well telescopes please sketch and show depths.

GROUND LEVEL

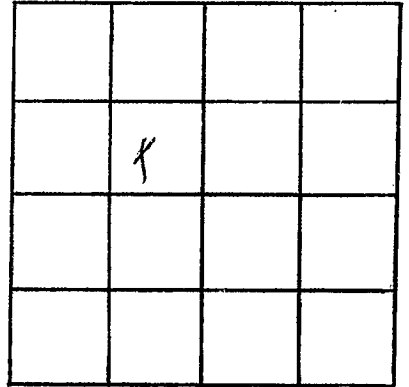

SECTION 28

Please indicate well location X.

ADDITIONAL INFORMATION

If more than one screen,  
show locations of each on sketch.