

MISSISSIPPI DEPARTMENT OF NATURAL RESOURCE

Bureau of Land and Water Resources

Southport Mall

P.O. Box 10631

Jackson, Mississippi 39209

WATER WELL DRILLERS LOG

WALTHALL
E 2072

June 10 1984
date well completed

Reiner Miller
firm name

Walthall
county well located

LANDOWNER:
M. C. Ard
Rt 3 Tipton
(mailing address)

description of formations encountered	from	to
Red Clay	0	210
Sand & Gravel	110	110
Gray Chalk	110	150
fine white sand	150	180
Coarse sand	180	202

WELL LOCATION:
sec. 7 T 2 N R 10 E
7 miles E-NE Tipton
(distance) (direction) (nearest town)

WELL PURPOSE: private
(home, irrigation, municipal, industrial)

WELL COMPLETION DATA:

- (1) diameter (inches) 4"
- (2) total depth (feet) 202
- (3) static water level (feet) 120' above top of ground.
- (4) casing plastic, baton
(material) (depth)
- (size) if telescope see back.
- (5) screen 6", 196'
(length) (depth to top)
- 4", plastic
(size) (material)
- (6) pump 3 hp, 12
(HP) (yield gpm)
- cat
(type power)
- (7) electric log no
(yes or no)
- (organization running log)

(8) how well bottom plugged
good work

DRILLERS REMARKS:
[Signature]


DEPT. OF NATURAL RESOURCES
BUREAU OF LAND & WATER RESOURCES

JUL 30 1984

RECEIVED

If well telescopes please sketch and show depths.

GROUND LEVEL

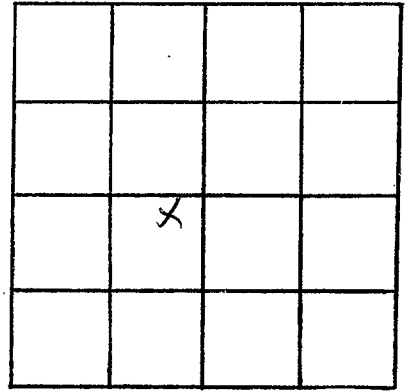

SECTION 7

Please indicate well location X.

ADDITIONAL INFORMATION

If more than one screen,
show locations of each on sketch.