

MISSISSIPPI DEPARTMENT OF NATURAL RESOURCES

Bureau of Land and Water Resources

Southport Mall

P.O. Box 10631

Jackson, Mississippi 39209

WATER WELL DRILLERS LOG


E 2074
 WALTHAM
 4-1-85

4-1 1985 *F. G. ...* firm name *Waltham* county well located

LANDOWNER:	description of formations encountered	from	to
<i>Ross Morris</i> <i>AR. Tipton</i> (mailing address)	<i>Red Clay</i> <i>Red Sand</i> <i>Green Sand & gravel</i>	12 20 38	15 38 51
WELL LOCATION: sec. <u>36</u> T <u>2</u> N R <u>10</u> E S W <u>8</u> miles <u>E</u> of <u>Tipton</u> (distance) (direction) (nearest town)			
WELL PURPOSE: <u>Home</u> (home, irrigation, municipal, industrial)			
WELL COMPLETION DATA:			
(1) diameter (inches) <u>4</u>			
(2) total depth (feet) <u>51</u>			
(3) static water level (feet) <u>20</u> below top of ground.			
(4) casing <u>PVC</u> , <u>41</u> , (material) (depth) <u>4</u> if telescope see back. (size)			
(5) screen <u>10</u> , <u>41</u> (length) (depth to top) <u>4</u> , <u>PVC</u> (size) (material)			
(6) pump <u>1/2</u> , <u>10</u> (HP) (yield gpm) <u>elm</u> (type power)			
(7) electric log <u>no</u> (yes or no)			
(organization running log)			
(8) how well bottom plugged <i>Seal bit</i>			
DRILLERS REMARKS:			

If well telescopes please sketch and show depths.

GROUND LEVEL

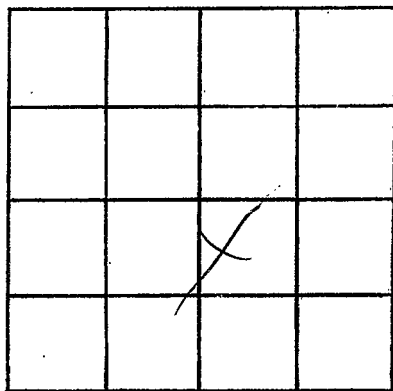

SECTION 36

Please indicate well location X.

ADDITIONAL INFORMATION

Multiple horizontal lines for writing additional information.

RECEIVED

APR 1 0 1985

If more than one screen, show locations of each on sketch.

Department of Natural Resources
Bureau of Land & Water Resources