

MISSISSIPPI DEPARTMENT OF NATURAL RESOURCES

Bureau of Land and Water Resources

Southport Mall

P.O. Box 10631

Jackson, Mississippi 39209

WATER WELL DRILLERS LOG

E 2075
Walthall
7-24 85

7-24 1985 date well completed
Fitzgerald Well Serv firm name
Walthall county well located

LANDOWNER:
Vincent Larsons
R.R. Tipton, MS
(mailing address)

description of formations encountered	from	to
Red clay	0	20
Red sand	20	90
Coarse sand & gravel	90	106

WELL LOCATION:
sec. 22 T 2 N R 10 E
S W
3 miles W of Tipton
(distance) (direction) (nearest town)

WELL PURPOSE: Flow
(home, irrigation, municipal, industrial)

- WELL COMPLETION DATA:
- (1) diameter (inches) 4
 - (2) total depth (feet) 106
 - (3) static water level (feet) 50 below above top of ground.
 - (4) casing PVC, 96,
(material) (depth)
4 if telescope see back.
(size)
 - (5) screen 10, 96
(length) (depth to top)
4, PVC
(size) (material)
 - (6) pump 1/2, 10
(HP) (yield gpm)
elec
(type power)
 - (7) electric log no
(yes or no)
(organization running log)
 - (8) how well bottom plugged Seal PBR


DRILLERS REMARKS:

RECEIVED
SEP 13 1985

Department of Natural Resources
Bureau of Land & Water Resources

If well telescopes please sketch and show depths.

GROUND LEVEL

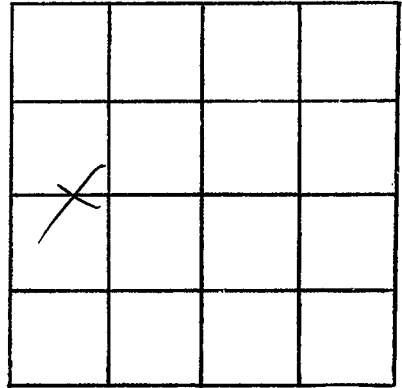

SECTION 22

Please indicate well location X.

ADDITIONAL INFORMATION

If more than one screen,
show locations of each on sketch.