

MISSISSIPPI DEPARTMENT OF NATURAL RESOURCES

Bureau of Land and Water Resources

Southport Mall

P.O. Box 10631

Jackson, Mississippi 39209

WATER WELL DRILLERS LOG

B2076
Walshall
8-5-85

8-5 1985 Fitzwallace Sew Walshall
date well completed firm name county well located

LANDOWNER:
Louaine Long
R.R. Tylutown Ms.
(mailing address)

description of formations encountered	from	to
<u>Red clay</u>	<u>0</u>	<u>20</u>
<u>Red sand</u>	<u>20</u>	<u>60</u>
<u>White chalk</u>	<u>60</u>	<u>110</u>
<u>Coarse sand & gravel</u>	<u>110</u>	<u>138</u>

WELL LOCATION:
sec. 26 T 2 N R 10 E
S W
2 miles W of Tylutown
(distance) (direction) (nearest town)

WELL PURPOSE: Home
(home, irrigation, municipal, industrial)

- WELL COMPLETION DATA:
- (1) diameter (inches) 4
 - (2) total depth (feet) 138
 - (3) static water level (feet) 85 below above top of ground.
 - (4) casing PVC, 128,
(material) (depth)
4
(size) if telescope see back.
 - (5) screen 10, 128
(length) (depth to top)
4, PVC
(size) (material)
 - (6) pump 1/2, 10
(HP) (yield gpm)
Elco
(type power)
 - (7) electric log No
(yes or no)
(organization running log)
 - (8) how well bottom plugged Sand plug


RECEIVED
SEP 18 1985

DRILLERS REMARKS:

Department of Natural Resources
Bureau of Land & Water Resources

If well telescopes please sketch and show depths.

GROUND LEVEL

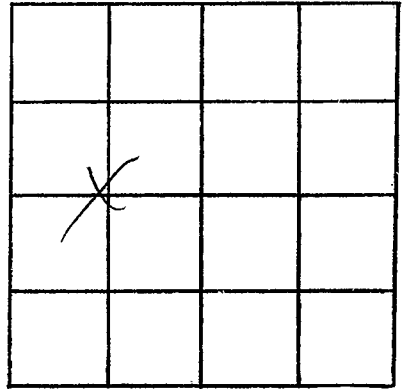

SECTION 26

Please indicate well location X.

ADDITIONAL INFORMATION

If more than one screen,
show locations of each on sketch.