

COALTIMM
WATHALL
E 2077
1-20-85

MISSISSIPPI
BOARD OF WATER COMMISSIONERS
416 North State Street
Jackson, Mississippi 39201

WATER WELL DRILLERS LOG

1/20/1985 Stafford Well Ser Wathall
date well completed firm name county well located

LANDOWNER: <u>Lawrence J. Ward</u>	description of formations encountered	from	to
	top soil	0	18"
(mailing address)	clay & gravel	18"	30'
WELL LOCATION: sec. <u>18</u> T. <u>20</u> N. R. <u>9</u> E <u>9</u> miles SW of <u>Tylertown</u> (distance) (direction) (nearest town)	fine sand	30'	50'
WELL PURPOSE: <u>Home</u> (home, irrigation, municipal, industrial)	sand & gravel	50'	82'
WELL COMPLETION DATA:			
(1) diameter (inches) <u>4"</u>			
(2) total depth (feet) <u>82'</u>			
(3) static water level (feet) <u>50</u> below above top of ground.			
(4) casing <u>Plastic</u> , <u>72'</u> (material) (depth)			
<u>4"</u> (size) if telescope see back.			
(5) screen <u>10'</u> , <u>72'</u> (length) (depth to top)			
<u>4"</u> , <u>Plastic</u> (size) (material)			
(6) pump <u>1/2</u> (HP) (yield gpm)			
<u>Electric</u> (type power)			
(7) electric log (yes or no) _____			
(organization running log) _____			
(8) how well bottom plugged <u>BWV</u>			


DRILLERS REMARKS:
Wade Brown Assisted
by Esley Stafford

RECEIVED
MAR 28 1985

Department of Natural Resources
Bureau of Land & Water Resources

If well telescopes please sketch and show depths.

GROUND LEVEL

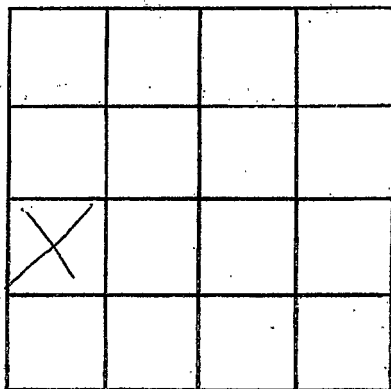

SECTION _____

Please indicate well location X.

ADDITIONAL INFORMATION

If more than one screen,
show locations of each on sketch.