

WALTHALL

E 2078

MISSISSIPPI DEPARTMENT OF NATURAL RESOURCES

Bureau of Land and Water Resources

Southport Mall

P.O. Box 10631

Jackson, Mississippi 39209

WATER WELL DRILLERS LOG

9-10
date well completed

19

85

Fitzgerald well log
firm name

Walthall
county well located

LANDOWNER:

Robert Golden

R.R. Tylertown Ms.
(mailing address)

WELL LOCATION:

sec. 7 T 2 N R 10 E
S W
7 miles W of Tylertown
(distance) (direction) (nearest town)

WELL PURPOSE: Home
(home, irrigation, municipal, industrial)

WELL COMPLETION DATA:


- (1) diameter (inches) 4
- (2) total depth (feet) 152
- (3) static water level (feet) 120 below above top of ground.
- (4) casing PVC, 142, (material) (depth) 4 (size) if telescope see back.
- (5) screen 10, 142 (length) (depth to top) 4 (size) PVC (material)
- (6) pump 3/4, 12 (HP) (yield gpm) Elec (type power)
- (7) electric log no (yes or no)
- (organization running log)
- (8) how well bottom plugged sand/shale

description of formations encountered

from

to

Red clay	0	20
Red sand	20	90
white chalk	90	140
Coarse sand & gravel	140	152

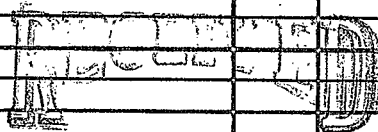


NOV 5 1985

Department of Natural Resources
Bureau of Land & Water Resources

DRILLERS REMARKS:

If well telescopes please sketch and show depths.

GROUND LEVEL

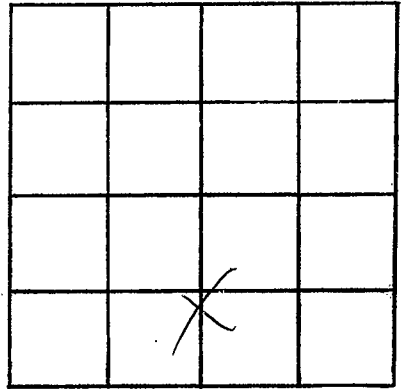

SECTION 2

Please indicate well location X.

ADDITIONAL INFORMATION

If more than one screen,
show locations of each on sketch.