

MISSISSIPPI DEPARTMENT OF NATURAL RESOURCES

Bureau of Land and Water Resources

Southport Mall

P.O. Box 10631

Jackson, Mississippi 39209

WATER WELL DRILLERS LOG

WALTHALL
E
2080

1-8
date well completed

1986
firm name

Fitzgerald Well Serv. Walthall

county well located


| LANDOWNER: | description of formations encountered | from | to |
|---|--|----------------|------------------|
| Wayne Deeks P.O. 3, Leighton, Miss. (mailing address) | Red clay Red sand Coarse sand & gravel | 0 20 168 | 20 168 180 |
| WELL LOCATION: sec. <u>9</u> T. <u>2</u> N. R. <u>10</u> E. S. W. <u>1 1/2</u> miles <u>N</u> of <u>MESA</u> (distance) (direction) (nearest town) | | | |
| WELL PURPOSE: <u>Home</u> (home, irrigation, municipal, industrial) | | | |
| WELL COMPLETION DATA: (1) diameter (inches) <u>4</u> (2) total depth (feet) <u>180</u> (3) static water level (feet) <u>90</u> below above top of ground. (4) casing <u>PVC</u> <u>170</u> (material) (depth) <u>4</u> if telescope see back. (size) (5) screen <u>10</u> <u>170</u> (length) (depth to top) <u>4</u> <u>PVC</u> (size) (material) (6) pump <u>1/2</u> <u>10</u> (HP) (yield gpm) <u>elm</u> (type power) (7) electric log <u>No</u> (yes or no) (organization running log) (8) how well bottom plugged <u>Sealed</u> | | | |
| DRILLERS REMARKS: | | | |

RECEIVED
JAN 30 1986

Department of Natural Resources
Bureau of Land & Water Resources

If well telescopes please
sketch and show depths.

GROUND LEVEL

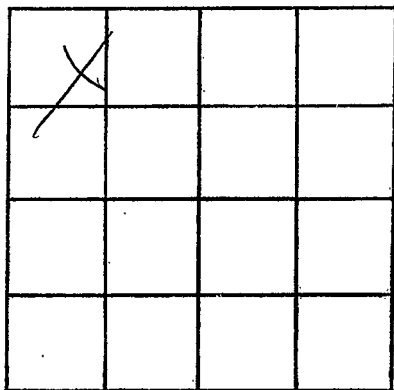

SECTION 9

Please indicate well location X.

ADDITIONAL INFORMATION

If more than one screen,
show locations of each on sketch.