

MISSISSIPPI DEPARTMENT OF NATURAL RESOURCES

Bureau of Land and Water Resources

Southport Mall

P.O. Box 10631


Jackson, Mississippi 39209

WATER WELL DRILLERS LOG

WALTHAM  
E 2081

8-7 1986 Flycatcher Land Waltham  
date well completed firm name county well located

LANDOWNER:	description of formations encountered	from	to
<u>Bill Power</u>			
<u>R.R. Tyburn, Inc.</u> (mailing address)	<u>Red clay</u>	<u>0</u>	<u>20</u>
	<u>Red sand</u>	<u>20</u>	<u>115</u>
	<u>Coarse sand &amp; gravel</u>	<u>115</u>	<u>129</u>
WELL LOCATION:			
sec. <u>11</u> T. <u>2</u> N. R. <u>10</u> E S W			
<u>2</u> miles <u>N</u> of <u>Tylertown</u> (distance) (direction) (nearest town)			
WELL PURPOSE:			
(home, irrigation, municipal, industrial) <u>Home</u>			
WELL COMPLETION DATA:			
(1) diameter (inches) <u>4</u>			
(2) total depth (feet) <u>129</u>			
(3) static water level (feet) <u>20</u> below above top of ground.			
(4) casing <u>PVC</u> , <u>129</u> (material) (depth)			
<u>4</u> (size) if telescope see back.			
(5) screen <u>10</u> , <u>119</u> (length) (depth to top)			
<u>4</u> , <u>PVC</u> (size) (material)			
(6) pump <u>1/2</u> , <u>10</u> (HP) (yield gpm)			
<u>elc</u> (type power)			
(7) electric log <u>No</u> (yes or no)			
(organization running log)			
(8) how well bottom plugged <u>Sealed</u>			

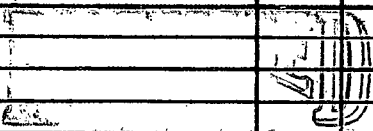


AUG 13 1986

Department of Natural Resources  
Bureau of Land & Water Resources

DRILLERS REMARKS:

If well telescopes please sketch and show depths.

GROUND LEVEL

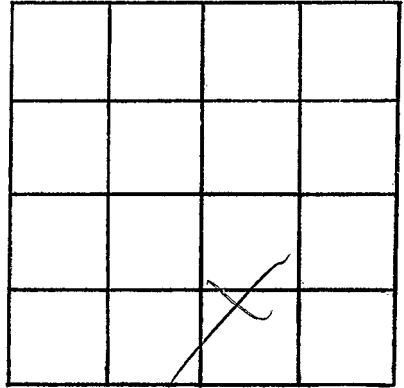

SECTION 11

Please indicate well location X.

ADDITIONAL INFORMATION

If more than one screen,  
show locations of each on sketch.