

MISSISSIPPI DEPARTMENT OF NATURAL RESOURCES
 Bureau of Land and Water Resources
 Southport Mall
 P.O. Box 10631
 Jackson, Mississippi 39209
WATER WELL DRILLERS LOG

WALTHALL
E ~~2083~~
2083

Aug 8 1986 Fitzgerald well serv WALTHALL
 date well completed firm name county well located

LANDOWNER:
Bevyl Scott
RR. Tylertown Ms.
 (mailing address)

description of formations encountered	from	to
<u>Red clay</u>	<u>0</u>	<u>20</u>
<u>Red sand</u>	<u>20</u>	<u>95</u>
<u>Red chalk</u>	<u>95</u>	<u>125</u>
<u>Coarse sand & gravel</u>	<u>125</u>	<u>145</u>

WELL LOCATION:
 sec. 35 T 2 N R 10 E
 S W
3 miles SSE of Tylertown
 (distance) (direction) (nearest town)

WELL PURPOSE: Home
 (home, irrigation, municipal, industrial)

- WELL COMPLETION DATA:
- (1) diameter (inches) 4
 - (2) total depth (feet) 145
 - (3) static water level (feet) 70 below above top of ground.
 - (4) casing 40 C, 135
 (material) (depth)
4 if telescope see back.
 (size)
 - (5) screen 10, 135
 (length) (depth to top)
4, 40 C
 (size) (material)
 - (6) pump 3/4, 15
 (HP) (yield gpm)
Elc
 (type power)
 - (7) electric log no
 (yes or no)
 (organization running log)
 - (8) how well bottom plugged Seal off


RECEIVED
SEP 9 0 1986

Department of Natural Resources
 Bureau of Land & Water Resources

DRILLERS REMARKS:

If well telescopes please sketch and show depths.

GROUND LEVEL

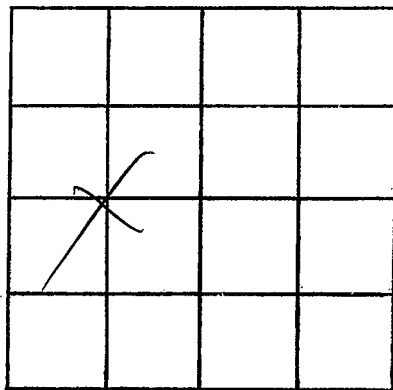

SECTION 35

Please indicate well location X.

ADDITIONAL INFORMATION

If more than one screen,
show locations of each on sketch.