

WALTMAN
E 2086

MISSISSIPPI DEPARTMENT OF NATURAL RESOURCES
Bureau of Land and Water Resources
Southport Mall
P.O. Box 10631
Jackson, Mississippi 39209
WATER WELL DRILLERS LOG

5-13 1987 date well completed
Fitzgerald Well Co. firm name
Walthall county well located

LANDOWNER:
Sylvester Jordan
B.R. Tylston, Ms.
(mailing address)

description of formations encountered	from	to
Red clay	0	20
Red sand	20	115
Coarse sand gravel	115	127

WELL LOCATION:
sec. 25 T-2 N R-10 E
S W
1/2 miles W of Tylston
(distance) (direction) (nearest town)

WELL PURPOSE: home
(home, irrigation, municipal, industrial)


- WELL COMPLETION DATA:
- (1) diameter (inches) 4
 - (2) total depth (feet) 127
 - (3) static water level (feet) 60 below above top of ground.
 - (4) casing PVC 117, (material) (depth)
4 (size) If telescope see back.
 - (5) screen 10 117 (length) (depth to top)
4 (size) PVC (material)
 - (6) pump 1/2 10 (HP) (yield gpm)
Elex (type power)
 - (7) electric log No (yes or no)
(organization running log)
 - (8) how well bottom plugged Sand OK

RECEIVED
JUN 15 1987
Department of Natural Resources
Bureau of Land & Water Resources

DRILLERS REMARKS:

If well telescopes please sketch and show depths.

GROUND LEVEL

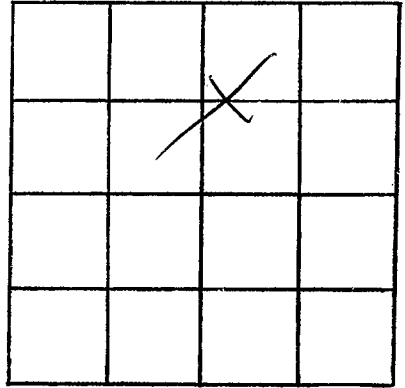

SECTION 25

Please indicate well location X.

ADDITIONAL INFORMATION

If more than one screen,
show locations of each on sketch.