

MISSISSIPPI DEPARTMENT OF NATURAL RESOURCES

Bureau of Land and Water Resources

COUNTY WELL LOCATED
Madison

WELL NUMBER
E

CODED

PERMIT NUMBER
2087

DATE WELL COMPLETED
5-6-87

PERMIT NUMBER
0287

NAME OF DRILLING FIRM
Reems Well Service

P.O. Box 10631
Jackson, Mississippi 39209
WATER WELL DRILLERS LOG

NAME & MAILING ADDRESS OF LANDOWNER
Tommy R. De Deauf
Tylertown Miss

WELL LOCATION: SEC 26 TOWNSHIP 2 RANGE 10
N 10 *W*

DISTANCE 1 Miles West of Tylertown

OTHER LANDMARK
near school

WELL PURPOSE Home, Irrigation, Municipal, Industrial, Fish Pond, etc.

PUMP DATA

PUMP TYPE (Circle One):
 Submersible Turbine Jet Flowing Well,
Other (Describe) _____

POWER TYPE (Circle One):
 Electric Tractor, Diesel, Gasoline, Butane,
Other (Describe) _____

Pump Capacity (GPM) 10 No. of Stages 8 Setting Depth 60 FT.

PUMP TEST

Well yielded 10 GPM with
a drawdown of 0 ft.
after 1 1/2 hours of pumping

WELL DATA

Well Depth <u>70</u>	Casing Diameter (In.) <u>4"</u>	Casing Length (Ft.) <u>60'</u>
Type of Casing <i>Plastic</i>	Hole Depth <u>70</u>	Depth to Static Water Level <u>45'</u>

TYPE OF COMPLETION: (Circle One or More):
 Gravel Packed, Underreamed, Telescoped,
 Natural Development Open Hole, Other

Top of Lap Pipe or Reduction in Casing
FEET IF TELESCOPED OR MORE THAN ONE SCREEN: USE BACK PAGE

LOG DATA

TYPE OF LOG RUN (Circle One):
 No Log Run, Electric, Gamma Ray, Density, Sonic, Neutron,
Other (Describe) _____

Name of Organization Running Log

SCREEN DATA

Diameter - Inches <u>4"</u>	Length - Feet <u>10'</u>	Slot Size - Inches <u>.012</u>
Screen Type <i>P.V.C</i>	Depth to Bottom - Feet <u>70ft</u>	

GEOLOGIC DATA (Office Use Only)

Surface Elev.	Geologic Unit	Unit Thickness	Depth to Top
Subs. SWL	Date	Analysis	Aquifer Test

Driller's Remarks

DESCRIPTION OF FORMATIONS ENCOUNTERED	FROM	TO
<i>Sandy Clay</i>	<u>0</u>	<u>14</u>
<i>Sand</i>	<u>14</u>	<u>35</u>
<i>Sand & Gravel</i>	<u>35</u>	<u>70</u>

FORMATIONS (Continued)

RECEIVED


JUN 29 1987

Department of Natural Resources
Bureau of Land & Water Resources

IF MORE SPACE IS NEEDED, USE BACK

If well telescopes please sketch and show depths.

GROUND LEVEL

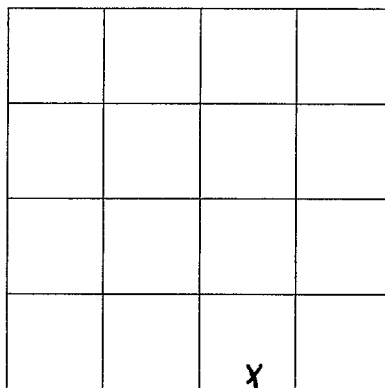

SECTION 26

Please indicate well location X.

ADDITIONAL INFORMATION

A series of horizontal lines provided for entering additional information.

If more than one screen, show location of each on sketch.