

MISSISSIPPI DEPARTMENT OF NATURAL RESOURCES

Bureau of Land and Water Resources

P.O. Box 10631

Jackson, Mississippi 39209

WATER WELL DRILLERS LOG

COUNTY WELL LOCATED Waltham	
WELL NUMBER E	CODED
DATE WELL COMPLETED NOV 10 87	

PERMIT NUMBER
NAME OF DRILLING FIRM FITZGERALD well service

NAME & MAILING ADDRESS OF LANDOWNER Everett Jones RR. Lytle town, MS.			
WELL LOCATION: SEC	TOWNSHIP	RANGE	
23	2^N	10^W	
DISTANCE	DIRECTION	NEAREST TOWN	
1 Miles	W	of Lytle town	
OTHER LANDMARK			
WELL PURPOSE: Home, Irrigation, Municipal, Industrial, Fish Pond, etc. Plant Domestic supply			


PUMP DATA		
PUMP-TYPE (Circle One): Submersible, Turbine, Jet, Flowing Well, Other (Describe) _____		
POWER-TYPE (Circle One): Electric, Tractor, Diesel, Gasoline, Butane, Other (Describe) _____		
Pump Capacity (GPM) 10	No. of Stages 10	Setting Depth 110 FT.
PUMP TEST		
Well yielded _____ GPM with a drawdown of _____ ft. after _____ hours of pumping		

WELL DATA		
Well Depth 170	Casing Diameter (In.) 4	Casing Length (Ft.) 160
Type of Casing PUC	Hole Depth 170	Depth to Static Water Level 75
TYPE OF COMPLETION: (Circle One or More): Gravel Packed, Underreamed, Telescoped, Natural Development, Open Hole, Other (Describe) _____		
Top of Lap Pipe or Reduction in Casing FEET IF TELESCOPED OR MORE THAN ONE SCREEN: USE BACK PAGE		

LOG DATA	
TYPE OF LOG RUN (Circle One): No Log Run, Electric, Gamma Ray, Density, Sonic, Neutron, Other (Describe) _____	
Name of Organization Running Log	


SCREEN DATA		
Diameter - Inches 4	Length - Feet 10	Slot Size - Inches #014
Screen Type PUC	Depth to Bottom - Feet 170	

GEOLOGIC DATA (Office Use Only)			
Surface Elev.	Geologic Unit	Unit Thickness	Depth to Top
Subs. SWL	Date	Analysis	Aquifer Test
Driller's Remarks			

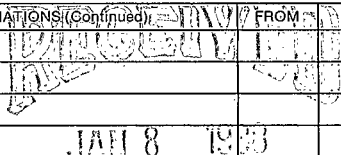DESCRIPTION OF FORMATIONS ENCOUNTERED	FROM	TO	FORMATIONS (Continued)	FROM	TO
Red CLAY	0	20			
Red SAND	20	80			
White CLAY	80	155			
COURSE SAND & GRAVEL	155	170			
Department of Natural Resources Bureau of Land & Water Resources					
IF MORE SPACE IS NEEDED, USE BACK					

If well telescopes please
sketch and show depths.

GROUND LEVEL

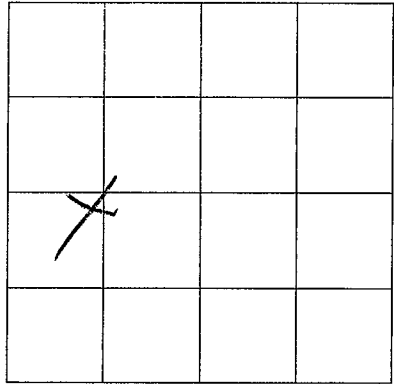

SECTION 23

Please indicate well location X.

ADDITIONAL INFORMATION

If more than one screen,
show location of each on sketch.