

MISSISSIPPI DEPARTMENT OF NATURAL RESOURCES
Bureau of Land and Water Resources
 Southport Mall
 P.O. Box 10631
 Jackson, Mississippi 39209
WATER WELL DRILLERS LOG

Waltham
E 2095

5-27-88 19 Amite Pump & Well Sup. Waltham
 date well completed By Ruth C. Neal firm name county well located

LANDOWNER: Ralph Payne
Rt 2 Box 208 P
McComb, Ms.
 (mailing address)

description of formations encountered	from	to
Clay & gr.	0	20
Sand & gr.	20	40
Clay	40	50
Sand & gr	50	100

WELL LOCATION: On back
 sec 23 T 2 N R 10 E
S W
 (distance) miles (direction) of (nearest town)

WELL PURPOSE: home
 (home, irrigation, municipal, industrial)

WELL COMPLETION DATA:
 (1) diameter (inches) 4
 (2) total depth (feet) 100
 (3) static water level (feet) 50 below/above top of ground.
 (4) casing Sch 40 pvc 90
 (material) (depth)
if telescope see back.
 (size)
 (5) screen 10'
 (length) (depth to top)
4" 014 Sch 40 pvc
 (size) (material)
 (6) pump 1/2 10
 (HP) (yield gpm)
220 elec.
 (type power)
 (7) electric log no
 (yes or no)
 (organization running log)

(8) how well bottom plugged backwash
valve

DRILLERS REMARKS:

RECEIVED


JUN 06 1988

Department of Natural Resources
 Bureau of Land & Water Resources

If well telescopes please sketch and show depths.

Franklinton, La. Hwy 27 to Tylertown, turn L on old Hwy 98, go 2 mi. see O'Quins used car lot. little drive directly in front of car lot. go about $\frac{1}{4}$ mi.

GROUND LEVEL

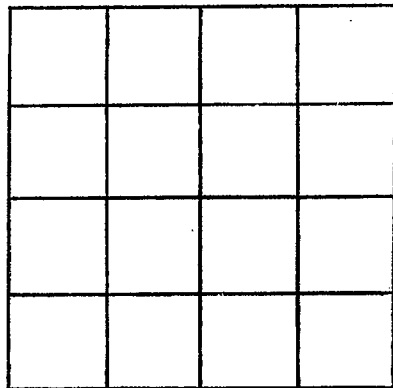

SECTION _____

Please indicate well location X.

ADDITIONAL INFORMATION

If more than one screen, show locations of each on sketch.