

WALTHALL
E 2104

MISSISSIPPI DEPARTMENT OF NATURAL RESOURCES
Bureau of Land and Water Resources
Southport Mall
P.O. Box 10631
Jackson, Mississippi 39209
WATER WELL DRILLERS LOG

Sept 12 1990 F. J. Sewell Well Serv Walthall
date well completed firm name county well located

LANDOWNER:	description of formations encountered	from	to
<u>A. Ogleson</u>	<u>Red Clay</u>	<u>0</u>	<u>10</u>
<u>P.R. Gledhill, Mrs.</u> (mailing address)	<u>Red Sand</u> <u>Green Sand & Gravel</u>	<u>10</u> <u>85</u>	<u>85</u> <u>99</u>
WELL LOCATION:			
sec. <u>20</u> T. <u>2</u> N R. <u>10</u> E S W			
<u>5</u> miles <u>W</u> of <u>Gledhill</u> (distance) (direction) (nearest town)			
WELL PURPOSE: <u>Home</u> (home, irrigation, municipal, industrial)			
WELL COMPLETION DATA:			
(1) diameter (inches) <u>4</u>			
(2) total depth (feet) <u>99</u>			
(3) static water level (feet) <u>70</u> below above top of ground.			
(4) casing <u>PVC</u> , <u>89</u> (material) (depth) <u>4</u> If telescope see back. (size)			
(5) screen <u>10</u> , <u>89</u> (length) (depth to top) <u>4</u> , <u>PVC</u> (size) (material)			
(6) pump <u>1/2</u> , <u>10</u> (HP) (yield gpm) <u>Ela</u> (type power)			
(7) electric log <u>no</u> (yes or no)			
(organization running log)			
(8) how well bottom plugged <u>Seal Shut</u>			


RECEIVED
SEP 27 1990

Department of Natural Resources
Bureau of Land & Water Resources

DRILLERS REMARKS:

If well telescopes please sketch and show depths.

GROUND LEVEL

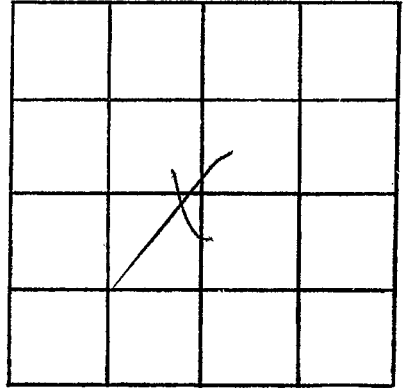

SECTION 20

Please indicate well location X.

ADDITIONAL INFORMATION

If more than one screen,
show locations of each on sketch.