

MISSISSIPPI DEPARTMENT OF NATURAL RESOURCES
Bureau of Land and Water Resources
 Southport Mall
 P.O. Box 10631
 Jackson, Mississippi 39209
WATER WELL DRILLERS LOG

WALTER
ESQ.

July 30 1990 FITZGERALD Well Service Covington
 date well completed firm name county well located

LANDOWNER:	description of formations encountered	from	to
<u>Winston McDonald</u>			
<u>R.R. Gledhill, Jr.</u> (mailing address)	<u>Red Clay</u> <u>Red Fine Sand</u> <u>Coarse Sand & Gravel</u>	<u>0</u> <u>20</u> <u>170</u>	<u>20</u> <u>120</u> <u>131</u>

WELL LOCATION:
 sec. 11 T. 2 N. R. 10 E.
 S. W.
3 miles N of Flycatcher
 (distance) (direction) (nearest town)

WELL PURPOSE:
 (home, irrigation, municipal, industrial) Home

WELL COMPLETION DATA:

(1) diameter (inches) 4

(2) total depth (feet) 131

(3) static water level (feet) 66 below above top of ground.

(4) casing PVC 121
 (material) (depth)

4 if telescope see back.
 (size)

(5) screen 10 121
 (length) (depth to top)

4 PVC
 (size) (material)

(6) pump 1/2 10
 (HP) (yield gpm)

Electric
 (type power)

(7) electric log no
 (yes or no)

(organization running log)

(8) how well bottom plugged Sealed


DRILLERS REMARKS:

RECEIVED
 AUG 17 1990

Department of Natural Resources
 Bureau of Land & Water Resources

If well telescopes please sketch and show depths.

GROUND LEVEL

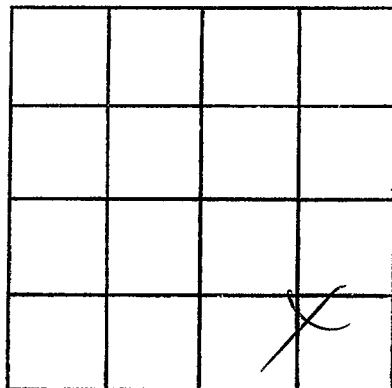

SECTION 11

Please indicate well location X.

ADDITIONAL INFORMATION

If more than one screen,
show locations of each on sketch.