

WALTMAN

MISSISSIPPI DEPARTMENT OF ENVIRONMENTAL QUALITY
Bureau of Land and Water Resources

P. O. Box 10631
Jackson, MS 39289-0631
WATER WELL DRILLERS LOG

COUNTY WELL LOCATED	
WELL NUMBER <u>E</u>	CODED
<u>2116</u>	
DATE WELL COMPLETED <u>Dec 30 91</u>	

PERMIT NUMBER
NAME OF DRILLING FIRM <u>Fitzgerald Well Serv</u>

NAME & MAILING ADDRESS OF LANDOWNER
Reed RASHING
RR 1 Glendon ms.

WELL LOCATION: SEC 24 TOWNSHIP 2 RANGE N 9 E
S 19 W

DISTANCE 7 Miles W of Glendon

OTHER LANDMARK

WELL PURPOSE: Home, Irrigation, Municipal, Industrial, Fish Pond, etc.
Home

PUMP DATA

PUMP TYPE (Circle One):
Submersible, Turbine, Jet, Flowing Well,
Other (Describe) _____

POWER TYPE (Circle One):
Electric, Tractor, Diesel, Gasoline, Butane,
Other (Describe) _____ H/P _____

Pump Capacity (GPM) <u>10</u>	No. of Stages <u>8</u>	Setting Depth <u>10</u> FT.
----------------------------------	---------------------------	--------------------------------

PUMP TEST

Well yielded 20 GPM with
a drawdown of 2 ft.
after 2 hours of pumping

WELL DATA

Well Depth <u>102</u>	Casing Diameter (In.) <u>4</u>	Casing Length (Ft.) <u>92</u>
Type of Casing <u>PVC</u>	Hole Depth <u>102</u>	Depth to Static Water Level <u>+3'</u>

TYPE OF COMPLETION: (Circle One or More):
Gravel Packed, Underreamed, Telescoped,
Natural Development, Open Hole, Other
(Describe) _____

Top of Lap Pipe or Reduction in Casing
FEET IF TELESCOPED OR MORE THAN ONE SCREEN: USE BACK PAGE

LOG DATA

TYPE OF LOG RUN (Circle One):
Electric, Gamma Ray, Density, Sonic, No Log Run,
Other (Describe) _____

Name of Organization Running Log

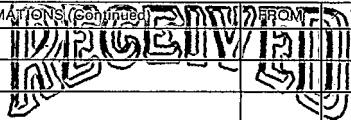
SCREEN DATA

Diameter - Inches <u>4</u>	Length - Feet <u>10</u>	Slot Size - Inches <u>10/10</u>
Screen Type <u>PVC</u>	Depth to Bottom - Feet <u>102</u>	

GEOLOGIC DATA (Office Use Only)

Surface Elev.	Geologic Unit	Unit Thickness	Depth to Top
Subs. SWL	Date	Analysis	Aquifer Test

Driller's Remarks

DESCRIPTION OF FORMATIONS ENCOUNTERED	FROM	TO	FORMATIONS (continued)	FROM	TO
<u>top soil</u>	<u>0</u>	<u>15</u>		<u>JAN 10 1992</u>	
<u>white chalk</u>	<u>5</u>	<u>12</u>			
<u>gravel</u>	<u>12</u>	<u>19</u>			
<u>blue chalk</u>	<u>19</u>	<u>91</u>			
<u>medium sand</u>	<u>91</u>	<u>102</u>			

Dept. of Environmental Quality
Bureau of Land & Water Resources

IF MORE SPACE IS NEEDED, USE BACK

If well telescopes please
sketch and show depths.

GROUND LEVEL

X			

SECTION 24

Please indicate well location X.

ADDITIONAL INFORMATION

If more than one screen,
show location of each on sketch.