

MISSISSIPPI DEPARTMENT OF ENVIRONMENTAL QUALITY

Office of Land and Water Resources

P. O. Box 10631
Jackson, MS 39289-0631
WATER WELL DRILLERS LOG

COUNTY WELL LOCATED <i>Crittend</i>	
WELL NUMBER E	CODED
DATE WELL COMPLETED <i>2119</i> October 7-92	

PERMIT NUMBER
NAME OF DRILLING FIRM <i>F. P. BIERBAUD Well Serv.</i>

NAME & MAILING ADDRESS OF LANDOWNER <i>Mae Funches</i> <i>R.R. 1, Lumberton, MS.</i>		
WELL LOCATION: SEC	TOWNSHIP	RANGE
<i>24</i>	<i>2</i>	<i>10</i>
	<i>N</i>	<i>E</i>
DISTANCE	DIRECTION	NEAREST TOWN
<i>6</i> Miles	<i>W</i>	of <i>Lumberton</i>
OTHER LANDMARK		
WELL PURPOSE: Home, Irrigation, Municipal, Industrial, Fish Pond, etc. <i>Home</i>		

PUMP DATA		
PUMP TYPE (Circle One): <input checked="" type="radio"/> Submersible, <input type="radio"/> Turbine, <input type="radio"/> Jet <input type="radio"/> Flowing Well, Other (Describe) _____		
POWER TYPE (Circle One): <input checked="" type="radio"/> Electric, <input type="radio"/> Tractor, <input type="radio"/> Diesel, <input type="radio"/> Gasoline, <input type="radio"/> Butane, Other (Describe) _____ H/P <i>1/2</i>		
Pump Capacity (GPM) <i>10</i>	No. of Stages <i>8</i>	Setting Depth <i>20</i> FT.
PUMP TEST		
Well yielded <i>20</i> GPM with a drawdown of <i>1</i> ft. after <i>2</i> hours of pumping		

WELL DATA		
Well Depth <i>116</i>	Casing Diameter (In.) <i>4</i>	Casing Length (Ft.) <i>106</i>
Type of Casing <i>AC</i>	Hole Depth <i>116</i>	Depth to Static Water Level <i>75</i>

LOG DATA	
TYPE OF LOG RUN (Circle One): <input checked="" type="radio"/> No-Log-Run, <input type="radio"/> Electric, <input type="radio"/> Gamma Ray, <input type="radio"/> Density, <input type="radio"/> Sonic, <input type="radio"/> Neutron, Other (Describe) _____	
Name of Organization Running Log	

TYPE OF COMPLETION: (Circle One or More): <input checked="" type="radio"/> Gravel Packed, <input type="radio"/> Underreamed, <input type="radio"/> Telescoped, <input type="radio"/> Natural Development, <input type="radio"/> Open Hole, <input type="radio"/> Other (Describe) _____	
--	--

WELL GROUTED TO A DEPTH OF <i>10</i> FEET Type Grout (circle one): Cement, Bentonite, or Mix

GEOLOGIC DATA (Office Use Only)			
Surface Elev.	Geologic Unit	Unit Thickness	Depth to Top
Subs. SWL	Date	Analysis	Aquifer Test


SCREEN DATA		
Diameter - Inches <i>4</i>	Length - Feet <i>10</i>	Slot Size - Inches <i>1014</i>
Screen Type <i>AC</i>	Depth to Bottom - Feet <i>116</i>	

Driller's Remarks

DESCRIPTION OF FORMATIONS ENCOUNTERED	FROM	TO	FORMATIONS (Continued)	FROM	TO
<i>Red clay with chert</i>	<i>0</i>	<i>20</i>	RECEIVED		
<i>Green sand</i>	<i>20</i>	<i>105</i>			
	<i>105</i>	<i>116</i>			
			DEC 07 1992		
			Dept. of Environmental Quality Bureau of Land & Water Resources		
IF MORE SPACE IS NEEDED, USE BACK					

If well telescopes please sketch and show depths.

GROUND LEVEL

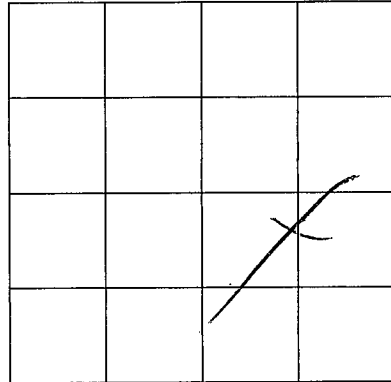

SECTION 24
Please indicate well location X.

ADDITIONAL INFORMATION

If more than one screen,
show location of each on sketch.