

**MISSISSIPPI DEPARTMENT OF ENVIRONMENTAL QUALITY**

Office of Land and Water Resources

P. O. Box 10631  
Jackson, MS 39289-0631  
**WATER WELL DRILLERS LOG**

COUNTY WELL LOCATED <i>Walton</i>	
WELL NUMBER <i>E</i>	CODED
DATE WELL COMPLETED <i>7-14 93</i>	

PERMIT NUMBER
NAME OF DRILLING FIRM <i>FITZGERALD Well serv</i>

NAME & MAILING ADDRESS OF LANDOWNER <i>James Norris</i>		
<i>RR. Tylertown ms.</i>		
WELL LOCATION: SEC	TOWNSHIP	RANGE
<i>25</i>	<i>2</i>	<i>N 10 E</i>
DISTANCE	DIRECTION	NEAREST TOWN
<i>7</i> Miles	<i>W</i>	<i>Tylertown</i>
OTHER LANDMARK		
WELL PURPOSE: Home, Irrigation, Municipal, Industrial, Fish Pond, etc. <i>Home</i>		

PUMP DATA		
PUMP TYPE (Circle One): Submersible, Turbine, Jet, Flowing Well, Other (Describe)		
POWER TYPE (Circle One): Electric, Tractor, Diesel, Gasoline, Butane, Other (Describe) <i>H/P 1/2</i>		
Pump Capacity (GPM) <i>10</i>	No. of Stages <i>8</i>	Setting Depth <i>50</i> FT.
PUMP TEST		
Well yielded <i>30</i> GPM with a drawdown of <i>2</i> ft. after <i>2</i> hours of pumping		

WELL DATA		
Well Depth <i>135</i>	Casing Diameter (In.) <i>4</i>	Casing Length (Ft.) <i>125</i>
Type of Casing <i>PVC</i>	Hole Depth <i>135</i>	Depth to Static Water Level <i>10</i>
TYPE OF COMPLETION: (Circle One or More): Gravel Packed, Underreamed, Telescoped, Natural Development, Open Hole, Other (Describe)		

LOG DATA	
TYPE OF LOG RUN (Circle One): Electric, Gamma Ray, Density, Sonic, <u>No Log Run</u> , Neutron, Other (Describe)	
Name of Organization Running Log	


WELL GROUTED TO A DEPTH OF <i>10</i> FEET
Type Grout (circle one): Cement, Bentonite, <u>or Mix</u>

GEOLOGIC DATA (Office Use Only)			
Surface Elev.	Geologic Unit	Unit Thickness	Depth to Top
Subs. SWL	Date	Analysis	Aquifer Test

SCREEN DATA		
Diameter - Inches <i>4</i>	Length - Feet <i>10</i>	Slot Size - Inches <i>.014</i>
Screen Type <i>PVC</i>	Depth to Bottom - Feet <i>135</i>	

Driller's Remarks

DESCRIPTION OF FORMATIONS ENCOUNTERED	FROM	TO
<i>Red clay</i>	<i>0</i>	<i>10</i>
<i>Red gravel</i>	<i>10</i>	<i>26</i>
<i>white chalk</i>	<i>26</i>	<i>122</i>
<i>Coarse sand &amp; gravel</i>	<i>122</i>	<i>135</i>

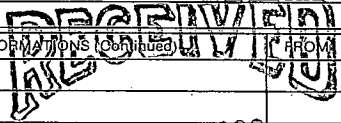

**OCT 18 1993**

Dept. of Environmental Quality  
Office of Land & Water Resources

FORMATIONS (continued)	FROM	TO

IF MORE SPACE IS NEEDED, USE BACK

If well telescopes please sketch and show depths.

GROUND LEVEL

X			

SECTION 25

Please indicate well location X.

ADDITIONAL INFORMATION

If more than one screen, show location of each on sketch.