

MISSISSIPPI DEPARTMENT OF ENVIRONMENTAL QUALITY

Office of Land and Water Resources

P. O. Box 10631
Jackson, MS 39289-0631
WATER WELL DRILLERS LOG

COUNTY WELL LOCATED
WALTON

WELL NUMBER E CODED

2123

DATE WELL COMPLETED
October 5-93

PERMIT NUMBER

NAME OF DRILLING FIRM
FITZGERALD Well Serv

NAME & MAILING ADDRESS OF LANDOWNER
Mr. Tom Stringer
P.O. Gylentown

WELL LOCATION: SEC 20 TOWNSHIP 2 RANGE 10 N S E W

DISTANCE 4 Miles W of Gylentown

OTHER LANDMARK

WELL PURPOSE: Home, Irrigation, Municipal, Industrial, Fish Pond, etc.
Home

PUMP DATA

PUMP TYPE (Circle One):
Submersible, Turbine, Jet, Flowing Well,
Other (Describe)

POWER TYPE (Circle One):
Electric, Tractor, Diesel, Gasoline, Butane,
Other (Describe) H/P 1/2

Pump Capacity (GPM) 10 No. of Stages 8 Setting Depth 130 FT.

PUMP TEST

Well yielded 25 GPM with
a drawdown of 2 ft.
after 2 hours of pumping

WELL DATA

Well Depth <u>169</u>	Casing Diameter (In.) <u>4</u>	Casing Length (Ft.) <u>159</u>
Type of Casing <u>PVC</u>	Hole Depth <u>169</u>	Depth to Static Water Level <u>100</u>

TYPE OF COMPLETION: (Circle One or More):
Gravel Packed, Underreamed, Telescoped,
Natural Development, Open Hole, Other
(Describe)

LOG DATA

TYPE OF LOG RUN (Circle One):
Electric, Gamma Ray, Density, Sonic, No Log Run, Neutron,
Other (Describe)

Name of Organization Running Log

WELL GROUTED TO A DEPTH OF 10 FEET
Type Grout (circle one): Cement, Bentonite, or Mix

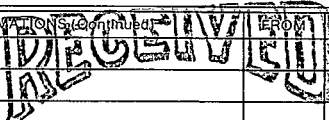
GEOLOGIC DATA (Office Use Only)

Surface Elev.	Geologic Unit	Unit Thickness	Depth to Top
Subs. SWL	Date	Analysis	Aquifer Test

SCREEN DATA

Diameter - Inches <u>4</u>	Length - Feet <u>10</u>	Slot Size - Inches <u>.014</u>
Screen Type <u>PVC</u>	Depth to Bottom - Feet <u>169</u>	

Driller's Remarks

DESCRIPTION OF FORMATIONS ENCOUNTERED	FROM	TO	FORMATIONS (Continued)	FROM	TO
<u>Red Clay</u>	<u>0</u>	<u>20</u>	 OCT 22 1993 Dept. of Environmental Quality Office of Land & Water Resources		
<u>Red SAND</u>	<u>20</u>	<u>154</u>			
<u>Coarse Sand & Gravel</u>	<u>154</u>	<u>169</u>			

IF MORE SPACE IS NEEDED, USE BACK

