

MISSISSIPPI DEPARTMENT OF ENVIRONMENTAL QUALITY

Office of Land and Water Resources

P. O. Box 10631  
Jackson, MS 39289-0631  
WATER WELL DRILLERS LOG

COUNTY WELL LOCATED  
Walthall

WELL NUMBER E CODED

2127

DATE WELL COMPLETED  
1-11-94

PERMIT NUMBER

NAME OF DRILLING FIRM  
F. T. GERARD Well Serv

NAME & MAILING ADDRESS OF LANDOWNER  
ALVIN BORDELON  
RR. Glendon Ms.

WELL LOCATION: SEC 24 TOWNSHIP 2 RANGE 10 N S E W

DISTANCE 1/2 Miles DIRECTION N NEAREST TOWN Walker B.P.

OTHER LANDMARK

WELL PURPOSE: Home, Irrigation, Municipal, Industrial, Fish Pond, etc.  
Home

PUMP DATA

PUMP TYPE (Circle One):  
 Submersible,  Turbine,  Jet  Flowing Well,  
Other (Describe) \_\_\_\_\_

POWER TYPE (Circle One):  
 Electric,  Tractor,  Diesel,  Gasoline,  Butane,  
Other (Describe) \_\_\_\_\_ H/P 1/2

Pump Capacity (GPM) <u>10</u>	No. of Stages <u>8</u>	Setting Depth <u>40</u> FT.
----------------------------------	---------------------------	--------------------------------

PUMP TEST

Well yielded 20 GPM with  
a drawdown of 0 ft.  
after 2 hours of pumping

WELL DATA

Well Depth <u>115</u>	Casing Diameter (In.) <u>4</u>	Casing Length (Ft.) <u>105</u>
Type of Casing <u>PVC</u>	Hole Depth <u>115</u>	Depth to Static Water Level <u>Flow</u>

TYPE OF COMPLETION: (Circle One or More):  
 Gravel Packed,  Underreamed,  Telescoped,  
 Natural Development,  Open Hole,  Other

LOG DATA

TYPE OF LOG RUN (Circle One):  
 No Log Run,  Electric,  Gamma Ray,  Density,  Sonic,  Neutron,  
Other (Describe) \_\_\_\_\_

Name of Organization Running Log

WELL GROUTED TO A DEPTH OF 20 FEET  
Type Grout (circle one): Cement, Bentonite, or Mix

GEOLOGIC DATA (Office Use Only)

Surface Elev.	Geologic Unit	Unit Thickness	Depth to Top
Subs. SWL	Date	Analysis	Aquifer Test

SCREEN DATA

Diameter - Inches <u>4</u>	Length - Feet <u>10</u>	Slot Size - Inches <u>10/10</u>
Screen Type <u>PVC</u>	Depth to Bottom - Feet <u>115</u>	

Driller's Remarks


DESCRIPTION OF FORMATIONS ENCOUNTERED	FROM	TO	FORMATIONS (Continued)	FROM	TO
<u>SAND</u>	<u>0</u>	<u>26</u>	<b>RECEIVED</b>  <b>FEB 11 1994</b>		
<u>Blue CLAY</u>	<u>26</u>	<u>100</u>			
<u>COURSE SAND</u>	<u>100</u>	<u>115</u>			

Dept. of Environmental Quality  
Office of Land & Water Resources

IF MORE SPACE IS NEEDED, USE BACK

If well telescopes please sketch and show depths.

GROUND LEVEL

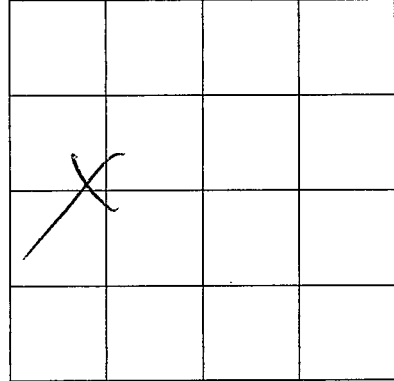

SECTION 24

Please indicate well location X.

ADDITIONAL INFORMATION

If more than one screen,  
show location of each on sketch.