

Walsh
E 2130

MISSISSIPPI
 BOARD OF WATER COMMISSIONERS
 416 North State Street
 Jackson, Mississippi 39201

WATER WELL DRILLERS LOG

APR 22 1994 FitzGerald Well Serv Walsh
 date well completed firm name county well located

LANDOWNER:
Phil Nugent
R.R. Lybourn MS -
 (mailing address)

description of formations encountered	from	to
<u>Reef Clay</u>	<u>2</u>	<u>18</u>
<u>Reef Sand</u>	<u>18</u>	<u>104</u>
<u>Coarse Sandstone</u>	<u>104</u>	<u>120</u>

WELL LOCATION:
 sec. 14 T. 2 N. R. 10 E
 S W
1 miles NW of Lybourn
 (distance) (direction) (nearest town)

WELL PURPOSE: Home
 (home, irrigation, municipal, industrial)

- WELL COMPLETION DATA:
- (1) diameter (inches) 4
 - (2) total depth (feet) 120
 - (3) static water level (feet) 45 below above top of ground.
 - (4) casing PVC 120
 (material) (depth)
4 if telescope see back.
 (size)
 - (5) screen 10 PVC
 (length) (depth to top)
4 PVC
 (size) (material)
 - (6) pump 1/2 10
 (HP) (yield gpm)
Elco
 (type power)
 - (7) electric log No
 (yes or no)
 (organization running log)
 - (8) how well bottom plugged Sandstone

RECEIVED


JUN 17 1994

Dept. of Environmental Quality
 Office of Land & Water Resources

DRILLERS REMARKS:

If well telescopes please sketch and show depths.

GROUND LEVEL

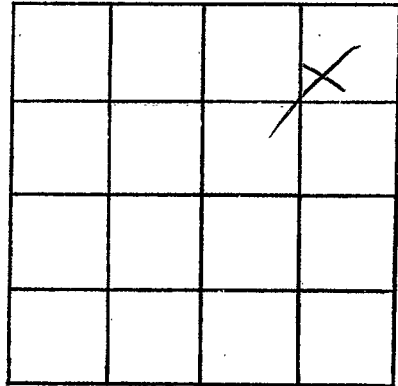

SECTION 14

Please indicate well location X.

ADDITIONAL INFORMATION

Lined area for additional information.

If more than one screen, show locations of each on sketch.