


WALTHALL
E 214
6-24-76

**MISSISSIPPI
 BOARD OF WATER COMMISSIONERS**
 416 North State Street
 Jackson, Mississippi 39201

WATER WELL DRILLERS LOG


6-24 1976 Fitzgerald Inc Walthall
 date well completed firm name county well located

LANDOWNER:	description of formations encountered	from	to
<u>Charles Mager</u> <u>R.R. Lytle</u> (mailing address)	<u>Red clay</u> <u>Red sand</u> <u>Coarse sand & gravel</u>	<u>0</u> <u>20</u> <u>135</u>	<u>20</u> <u>130</u> <u>143</u>
WELL LOCATION: sec. <u>4</u> T. <u>2</u> (N) R. <u>10</u> (E) <u>5</u> miles <u>NW</u> of <u>Lytle</u> (distance) (direction) (nearest town)			
WELL PURPOSE: (home, irrigation, municipal, industrial) <u>Home</u>			
WELL COMPLETION DATA:			
(1) diameter (inches) <u>4</u>			
(2) total depth (feet) <u>143</u>			
(3) static water level (feet) <u>90</u> below above top of ground.			
(4) casing <u>PVC</u> <u>135</u> (material) (depth) <u>4</u> if telescope see back. (size)			
(5) screen <u>8</u> <u>135</u> (length) (depth to top)			
(6) pump <u>4</u> <u>PVC</u> (size) (material) <u>1/2</u> <u>10</u> (HP) (yield gpm)			
<u>Electric</u> (type power)			
(7) electric log <u>no</u> (yes or no)			
(organization running log)			
(8) how well bottom plugged <u>Seal</u>			
DRILLERS REMARKS:			


 JUN - 1 1976
 MISS. BD. OF WATER COM.

If well telescopes please sketch and show depths.

GROUND LEVEL

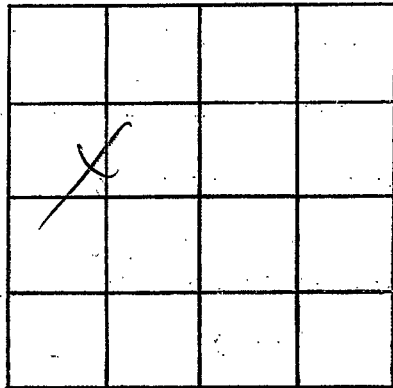

SECTION 4

Please indicate well location X.

ADDITIONAL INFORMATION

If more than one screen, show locations of each on sketch.