

MISSISSIPPI DEPARTMENT OF ENVIRONMENTAL QUALITY

Office of Land and Water Resources

P. O. Box 10631
Jackson, MS 39289-0631

WATER WELL DRILLERS LOG

COUNTY WELL LOCATED
WAITHALL

WELL NUMBER **E 2178** CODED

DATE WELL COMPLETED
12/4/96

PERMIT NUMBER **0-508**

NAME OF DRILLING FIRM
Jordan Well Ser.

NAME & MAILING ADDRESS OF LANDOWNER
Clyde Toney
Tylertown, Miss.

WELL LOCATION: SEC **2** TOWNSHIP **2^N** RANGE **10^W**

DISTANCE **4** Miles **W** DIRECTION of **Tylertown** NEAREST TOWN

OTHER LANDMARK

WELL PURPOSE Home Irrigation, Municipal, Industrial, Fish Pond, etc.

PUMP DATA

PUMP TYPE (Circle One):
Submersible, Turbine, Jet, Flowing Well,
Other (Describe) _____

POWER TYPE (Circle One):
Electric, Tractor, Diesel, Gasoline, Butane,
Other (Describe) _____ H/P _____

Pump Capacity (GPM) _____ No. of Stages _____ Setting Depth _____ FT.

PUMP TEST

Well yielded _____ GPM with
a drawdown of _____ ft.
after _____ hours of pumping

WELL DATA

Well Depth 175	Casing Diameter (In.) 2 1/4	Casing Length (Ft.) 165
Type of Casing Pvc	Hole Depth 175	Depth to Static Water Level Flow

TYPE OF COMPLETION: (Circle One or More):
Gravel Packed, Underreamed, Telescoped,
Natural Development, Open Hole, Other
(Describe) _____

WELL GROUTED TO A DEPTH OF **10** FEET
Type Grout (circle one): Cement, Bentonite, or Mix

LOG DATA

TYPE OF LOG RUN (Circle One):
No Log Run, Electric, Gamma Ray, Density, Sonic, Neutron,
Other (Describe) _____

Name of Organization Running Log

SCREEN DATA

Diameter - Inches 2	Length - Feet 10	Slot Size - Inches 10/10
Screen Type Pvc	Depth to Bottom - Feet 165	

GEOLOGIC DATA (Office Use Only)

Surface Elev.	Geologic Unit	Unit Thickness	Depth to Top
Subs. SWL	Date	Analysis	Aquifer Test

Driller's Remarks

RECEIVED

Top of Lap Rip or Reducer in Casing _____ FEET


IF TELESCOPED OR MORE THAN ONE SCREEN: USE BACK PAGE

DESCRIPTION OF FORMATIONS ENCOUNTERED	FROM	TO	FORMATIONS (Continued)	FROM	TO
top Soil	0	1	10-1996		
Sandy Clay	1	10	Dept. of Environmental Quality, Office of Land & Water Resources		
Sand & Gravel	10	35			
Shale	35	90			
fine Sand	90	140			
Sand & Gravel	140	175			

IF MORE SPACE IS NEEDED, USE BACK

If well telescopes please sketch and show depths.

GROUND LEVEL

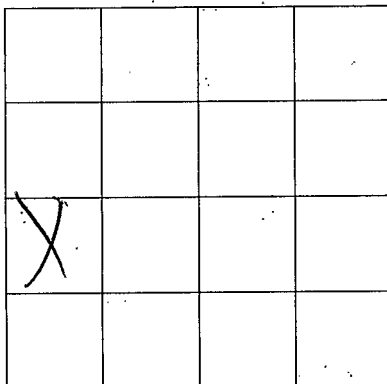

SECTION 2

Please indicate well location X.

ADDITIONAL INFORMATION

If more than one screen,
show location of each on sketch.