


If well telescopes please sketch and show depths.

GROUND LEVEL

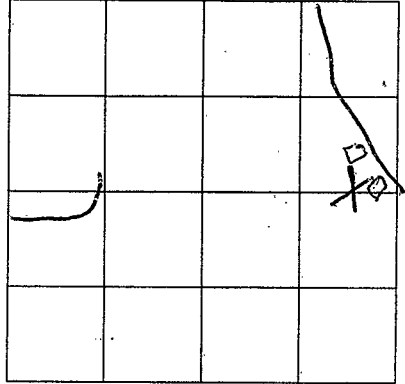

SECTION 3

Please indicate well location X.

ADDITIONAL INFORMATION

RECEIVED

NOV 10 1964

WATER RESOURCES DIVISION
U.S. GEOLOGICAL SURVEY

If more than one screen,
show location of each on sketch.