

(1) Owner of Land: Tyler town, Miss.
 (Name)
City Hall Tyler town Miss
 (Address)
 (2) Location: 1/4, 1/4, Sec. 20 T 20 R 11
W
 _____ miles _____ of _____
 (distance) (direction) (Nearest Town)
 (3) Topography: _____
 (Hilly) (Flat) (Level)
 (4) Purpose of Well: Municipal
 (Domestic Irrigation
 Municipal, Industrial, Other)


Description & Color of Materials Sand, Clay, Red Clay, Shell, etc.	Thick- ness Feet	Depth Feet
Sand	10	10
Gravel	4	14
White Clay	16	26
Blue Clay	30	56
Pink Clay	149	205
Blue shale	23	228
Silt sand	50	278
Sand	82	360

Information upon completion of well:

(1) Diameter 10" 10 inches. 17" hole
 (2) Total Depth 357 feet.
 (3) Water Level ± A feet below top of ground.
 (4) Cased to 294', Size 10" I.D.
 (5) Screen: Size 8", Length 60 ft.
 (6) Were any formations sealed against pollution?
Yes, _____ no.

If YES depth of formation Cemented full
length of 10" casing
 Why _____

Drillers Remarks: _____

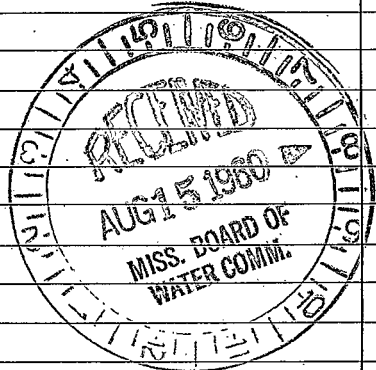

(Use Back Side)

7