

F 16

1-19-61 CODED

Date: 1-19-61, 1961, Driller: W.S. Fitzgerald County ~~Waltham~~

(Name)

Waltham

(1) Owner of Land: Noel Fortenberry

(Name)

Tylertown MS

(Address)

(2) Location: S 1/2 SW 1/4, Sec 36 T2R11

6 miles SE of Tylertown (distance) (direction) (Nearest Town)

(3) Topography: Hilly

(Hilly) (Flat) (Level)

(4) Purpose of Well: Dairy Farm

(Domestic Irrigation Municipal, Industrial, Other)

| Description & Color of Materials Sand, Clay, Red Clay, Shell, etc. | Thick- ness Feet | Depth Feet |
|---|------------------------|---------------|
| Top Soil + clay | 0 | 30 |
| Red sand | 30 | 75 |
| Sand + gravel | 75 | 90 |
| Red Chalk | 90 | 180 |
| Fine sand | 100 | 120 |
| Sand + gravel | 135 | 135 |

Information upon completion of well:


- (1) Diameter 4 inches.
- (2) Total Depth 135 feet.
- (3) Water Level 95 feet below top of ground.
- (4) Cased to 130, Size 4"
- (5) Screen: Size 2", Length 8'
- (6) Were any formations sealed against pollution?
yes, no.

If YES depth of formation _____

Why _____

Drillers Remarks: _____

CODED

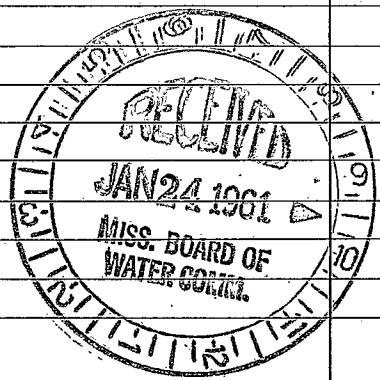

(Use Back Side)

Well No.

