

WALTHALL

F 17

6-18-71

MISSISSIPPI BOARD OF WATER COMMISSIONERS  
416 North State Street  
Jackson, Mississippi 39201

**CODED**

WATER WELL DRILLERS LOG

6-18  
date well completed

1971  
firm name

Fitzgerald Well Co

Walthall  
county well located

LANDOWNER:

Douglas Smith

R.R. Tylburn  
(mailing address)

description of formations encountered

from

to

Red clay

0

10

White clay

10

40

coarse sand & gravel

40

66

WELL LOCATION:

sec 33 T 20 N R 11 E S

2 miles SE of Tylburn  
(distance) (direction) (nearest town)

WELL PURPOSE:

Home  
(home, irrigation, municipal, industrial)

WELL COMPLETION DATA:

- (1) diameter (inches) 4
- (2) total depth (feet) 66
- (3) static water level (feet) 10 below top of ground.

- (4) casing (material) Plastic (depth) 60  
4 (size) if telescope see back.

- (5) screen (length) 6 (depth to top) 60  
4 (size) Plastic (material)

- (6) pump 1/2 (HP) 15 (yield gpm)  
Electric (type power)

- (7) electric log (yes or no)

(organization running log)

- (8) how well bottom plugged covered

**CODED**


JUL 24 1971

DRILLERS REMARKS:

MISS. BD. OF WATER COMMISSIONERS

If well telescopes please sketch and show depths.

GROUND LEVEL

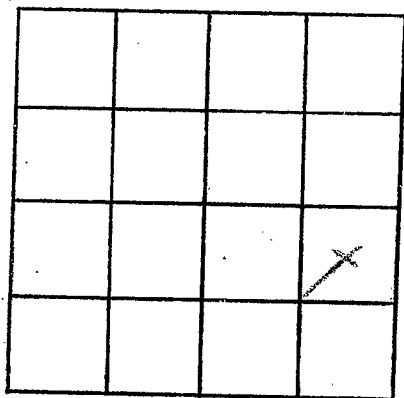

SECTION 53

Please indicate well location X.

ADDITIONAL INFORMATION

If more than one screen,  
show locations of each on sketch.