

WALTHAM MISSISSIPPI BOARD OF WATER COMMISSIONERS


F 19 CODED
4-7-66

WATER WELL DRILLERS LOG

Date: 4/7, 1966, Driller: T. B. Andrews County Waltham
(Name)

	Description & Color of Materials Sand, Clay, Red Clay, Shell, etc.	Thick- ness Feet	Depth Feet
(1) Owner of Land: <u>Lewis Guyton</u> <u>Leased to Tylertown Plant</u> <u>Tylertown, Miss</u> (Name) (Address)	0' to 50' Clay		
(2) Location: <u>1/4, 1/4, Sec. 11 T2R11E</u> <u>7</u> miles <u>N. E.</u> of <u>Tylertown</u> (distance) (direction) (Nearest Town)	50' to 110' Sand		
(3) Topography: _____ (Hilly) (Flat) (Level)	110' to 130'		
(4) Purpose of Well: <u>Domestic</u> (Domestic Irrigation Municipal, Industrial, Other)	Grey Clay		
Information upon completion of well:	130' to 140'		
(1) Diameter <u>4</u> inches.	Gravel		
(2) Total Depth <u>140'</u> feet.			
(3) Water Level <u>120'</u> feet below top of ground.			
(4) Cased to <u>140'</u> , Size <u>4"</u>			
(5) Screen: Size <u>None</u> , Length <u>✓</u>			
(6) Were any formations sealed against pollution? _____ yes, <u>✓</u> no.			
If YES depth of formation _____			
Why _____			
Drillers Remarks: <u>Plastic well</u>			

CODED

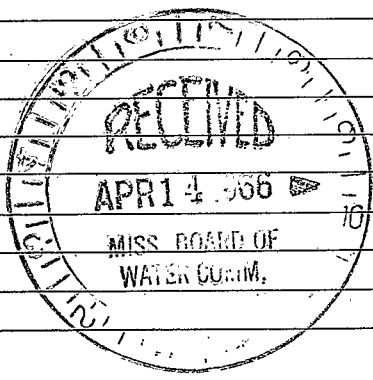

4

Well No.

(Use Back Side)

