

MISSISSIPPI

BOARD OF WATER COMMISSIONERS

416 North State Street

Jackson, Mississippi 39201

WATER WELL DRILLERS LOG

Waitkall

F22

8-66

INDEXED

8-2  
date well completed

1966 Fitzgerald Well Service  
firm name

Waitkall  
county well located

LANDOWNER:

Albert Magee

description of formations encountered

from

to

Kokomo - Miss

Top soil & clay

0 35

Red sand

55 90

Sand & gravel

20 110

Chalky sand

40 150

Sand & gravel

80 170

White Chalk

170

(mailing address)

WELL LOCATION:

sec. 11 T. 2 N. R. 11 E. S. 10 miles E of Taylor town (distance) (direction) (nearest town)

WELL PURPOSE:

home (home, irrigation, municipal, industrial)

WELL COMPLETION DATA:

(1) diameter (inches) 4

(2) total depth (feet) 168

(3) static water level (feet) 100 below top of ground.

(4) casing plastic, 160 (material) (depth)

4 (size) if telescope see back.

(5) screen 8' 160 (length) (depth to top)

4" plastic (size) (material)

(6) pump 3/4 HP 7 (HP) (yield gpm)

Spec (type power)


(7) electric log No (yes or no)

(organization running log)

(8) how well bottom plugged No mud peg


DRILLERS REMARKS:

INDEXED

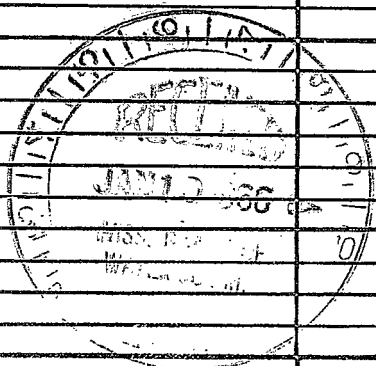

If well telescopes please sketch and show depths.

GROUND LEVEL

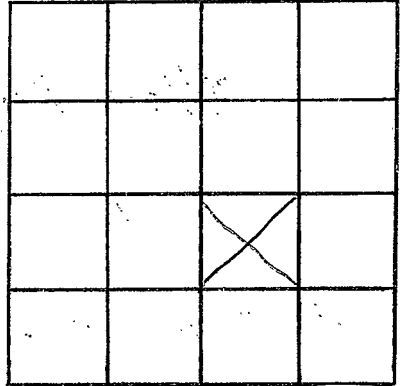

SECTION \_\_\_\_\_

Please indicate well location X.

ADDITIONAL INFORMATION

If more than one screen,  
show locations of each on sketch.