

WALTHALL
F24

8-2-66 MISSISSIPPI BOARD OF WATER COMMISSIONERS

CODED

WATER WELL DRILLERS LOG

Date: 8-2, 1966, Driller: Nic Fitzgerald County Walthall
(When well drilled) (Name) (Where well is located)

(1) Owner of Land: Hilbert Magee
(Name)
Ko Komo
(Address)

(2) Location: 1/4, 1/4, Sec. 11 T2 R11E
10 miles E of Tyfortown
(distance) (direction) (Nearest Town)

(3) Topography: /
(Hills) (Flat) (Level)

(4) Purpose of Well: /
(Domestic Irrigation
Municipal, Industrial, Other)

Description & Color of Materials Sand, Clay, Red Clay, Shell, etc.	Thick- ness Feet	Depth Feet
<u>Top Soil + Clay</u>	<u>0</u>	<u>25</u>
<u>Red Sand</u>	<u>35-90</u>	
<u>Sand + gravel</u>	<u>90</u>	<u>110</u>
<u>Sand + Chalk</u>	<u>110</u>	<u>150</u>
<u>Sand + gravel</u>	<u>150</u>	<u>190</u>
<u>White Chalk</u>	<u>190</u>	

Information upon completion of well:

(1) Diameter 4 inches.

(2) Total Depth 168 feet.

(3) Water Level 100 feet below top of ground.

(4) Cased to 160, Size 4

(5) Screen: Size 4, Length 8

(6) Were any formations sealed against pollution?
/ yes, / no.

If YES depth of formation _____
Why _____


Drillers Remarks: _____

Yield in gpm: _____

Size pump: 1/2 Submersible

Type power: 3/0

CODED

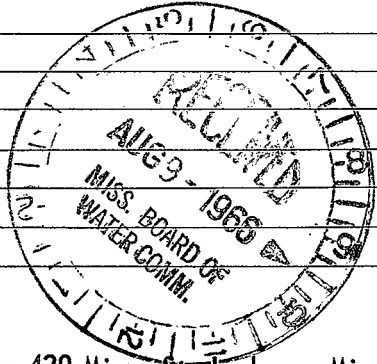

Mail this copy to Board of Water Commissioners 429 Miss. St. Jackson, Miss.

