

Walthall
F26
12-66

MISSISSIPPI BOARD OF WATER COMMISSIONERS

CODED

WATER WELL DRILLERS LOG

Date: 12/20, 1966, Driller: T. B. Andrews County Walthall
(When well drilled) (Name) (Where well is located)

(1) Owner of Land: A. B. Reegan
(Name)
Rt. 7 Tybertown, Miss
(Address)

(2) Location: NW 1/4, NW 1/4, Sec. 36 T2 R11,
5 miles S.E. of Tybertown
(distance) (direction) (Nearest Town)

(3) Topography: LEVEL
(Hilly) (Flat) (Level)

(4) Purpose of Well: Domestic
(Domestic Irrigation
Municipal, Industrial, Other)

Description & Color of Materials Sand, Clay, Red Clay, Shell, etc.	Thick- ness Feet	Depth Feet
<u>Red Clay</u>	<u>45</u>	<u>45'</u>
<u>Sand</u>	<u>30</u>	<u>75'</u>
<u>gravel</u>	<u>20</u>	<u>95'</u>
<u>Chalk</u>	<u>5</u>	<u>100'</u>
<u>Sand / pea gravel</u>	<u>26</u>	<u>126'</u>

Information upon completion of well:

(1) Diameter 4 inches.

(2) Total Depth 126 feet.

(3) Water Level 100 feet below top of ground.

(4) Cased to 126', Size 4"

(5) Screen: Size 4", Length 6'

(6) Were any formations sealed against pollution?
yes, no.

CODED

If YES depth of formation _____


Why _____

Drillers Remarks: 4" Plastic

Yield in gpm: 7

Size pump: 3/4 h.p.

Type power: _____

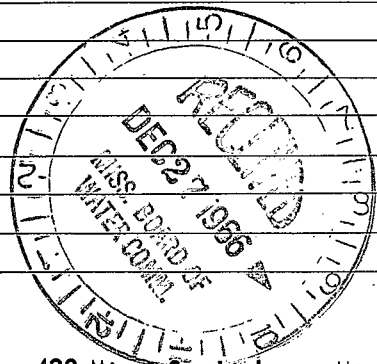

25

