

Walthall  
F 27  
2-67

**CODED**

MISSISSIPPI  
 BOARD OF WATER COMMISSIONERS  
 416 North State Street  
 Jackson, Mississippi 39201

**WATER WELL DRILLERS LOG**

2/10 1967 Andy's Drilling Co. Walthall  
 date well completed. firm name county well located

LANDOWNER: Beatrice Jones  
Rt. 1 Box K-6 Tylertown  
 (mailing address) Miss

WELL LOCATION:  
 sec. 9 T. 2 N. R. 11 E.  
5 miles N.E. of Tylertown  
 (distance) (direction) (nearest town)

description of formations encountered	from	to
<u>Red Clay</u>	<u>0</u>	<u>80</u>
<u>gray Chalk</u>	<u>80</u>	<u>100'</u>
<u>sand</u>	<u>100'</u>	<u>110'</u>
<u>Chalk</u>	<u>110'</u>	<u>170'</u>
<u>Coarse Sand / gravel</u>	<u>170'</u>	<u>190'</u>

WELL PURPOSE: Home  
 (home, irrigation, municipal, industrial)

WELL COMPLETION DATA:

(1) diameter (inches) 4"

(2) total depth (feet) 190'

(3) static water level (feet) 100' below top of ground.

(4) casing Plastic, 184'  
 (material) (depth)

         if telescope see back.  
 (size)

(5) screen 6', 190'  
 (length) (depth to top)

4", Plastic  
 (size) (material)

(6) pump 1 10  
 (HP) (yield gpm)


Elec. 220  
R.E.H. (type power)

(7) electric log No  
 (yes or no)

          
 (organization running log)

(8) how well bottom plugged Back  
Wash Valve

**CODED**

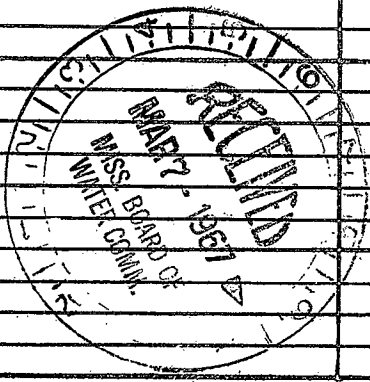

DRILLERS REMARKS:

If well telescopes please sketch and show depths.

GROUND LEVEL

			X

SECTION 9

Please indicate well location X.

ADDITIONAL INFORMATION

If more than one screen, show locations of each on sketch.