

**MISSISSIPPI  
BOARD OF WATER COMMISSIONERS**  
416 North State Street  
Jackson, Mississippi 39201

**WATER WELL DRILLERS LOG**

Walthall  
F28  
5-67 **CODED**

May 1 1967 Fitzgerald Well Service Walthall  
date well completed firm name county well located

LANDOWNER: A. W. Forbes  
Rt 2, Tylertown  
(mailing address)


description of formations encountered	from	to
<u>Red clay</u>	<u>0</u>	<u>10</u>
<u>Red chert</u>	<u>10</u>	<u>60</u>
<u>Red sand</u>	<u>60</u>	<u>80</u>
<u>Coarse sand &amp; gravel</u>	<u>80</u>	<u>95</u>

WELL LOCATION:  
sec 35 T 2 N R 11 E  
6 miles SE of Tylertown  
(distance) (direction) (nearest town)

WELL PURPOSE: Home  
(home, irrigation, municipal, industrial)

- WELL COMPLETION DATA:
- (1) diameter (inches) 4
  - (2) total depth (feet) 95
  - (3) static water level (feet) 70 below above top of ground.
  - (4) casing Plastic, 87,  
(material) (depth)  
4" if telescope see back.  
(size)
  - (5) screen 8', 87  
(length) (depth to top)  
4", Plastic  
(size) (material)
  - (6) pump ? ?  
(HP) (yield gpm)  
elect  
(type power)
  - (7) electric log no  
(yes or no)  
  
(organization running log)
  - (8) how well bottom plugged wood peg


**CODED**

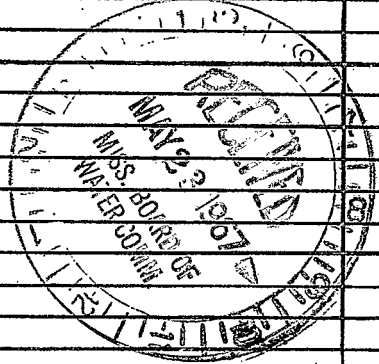

DRILLERS REMARKS:

If well telescopes please sketch and show depths.

GROUND LEVEL

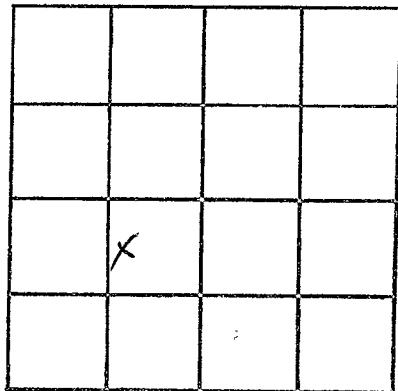

SECTION 35

Please indicate well location X.

ADDITIONAL INFORMATION

If more than one screen,  
show locations of each on sketch.